



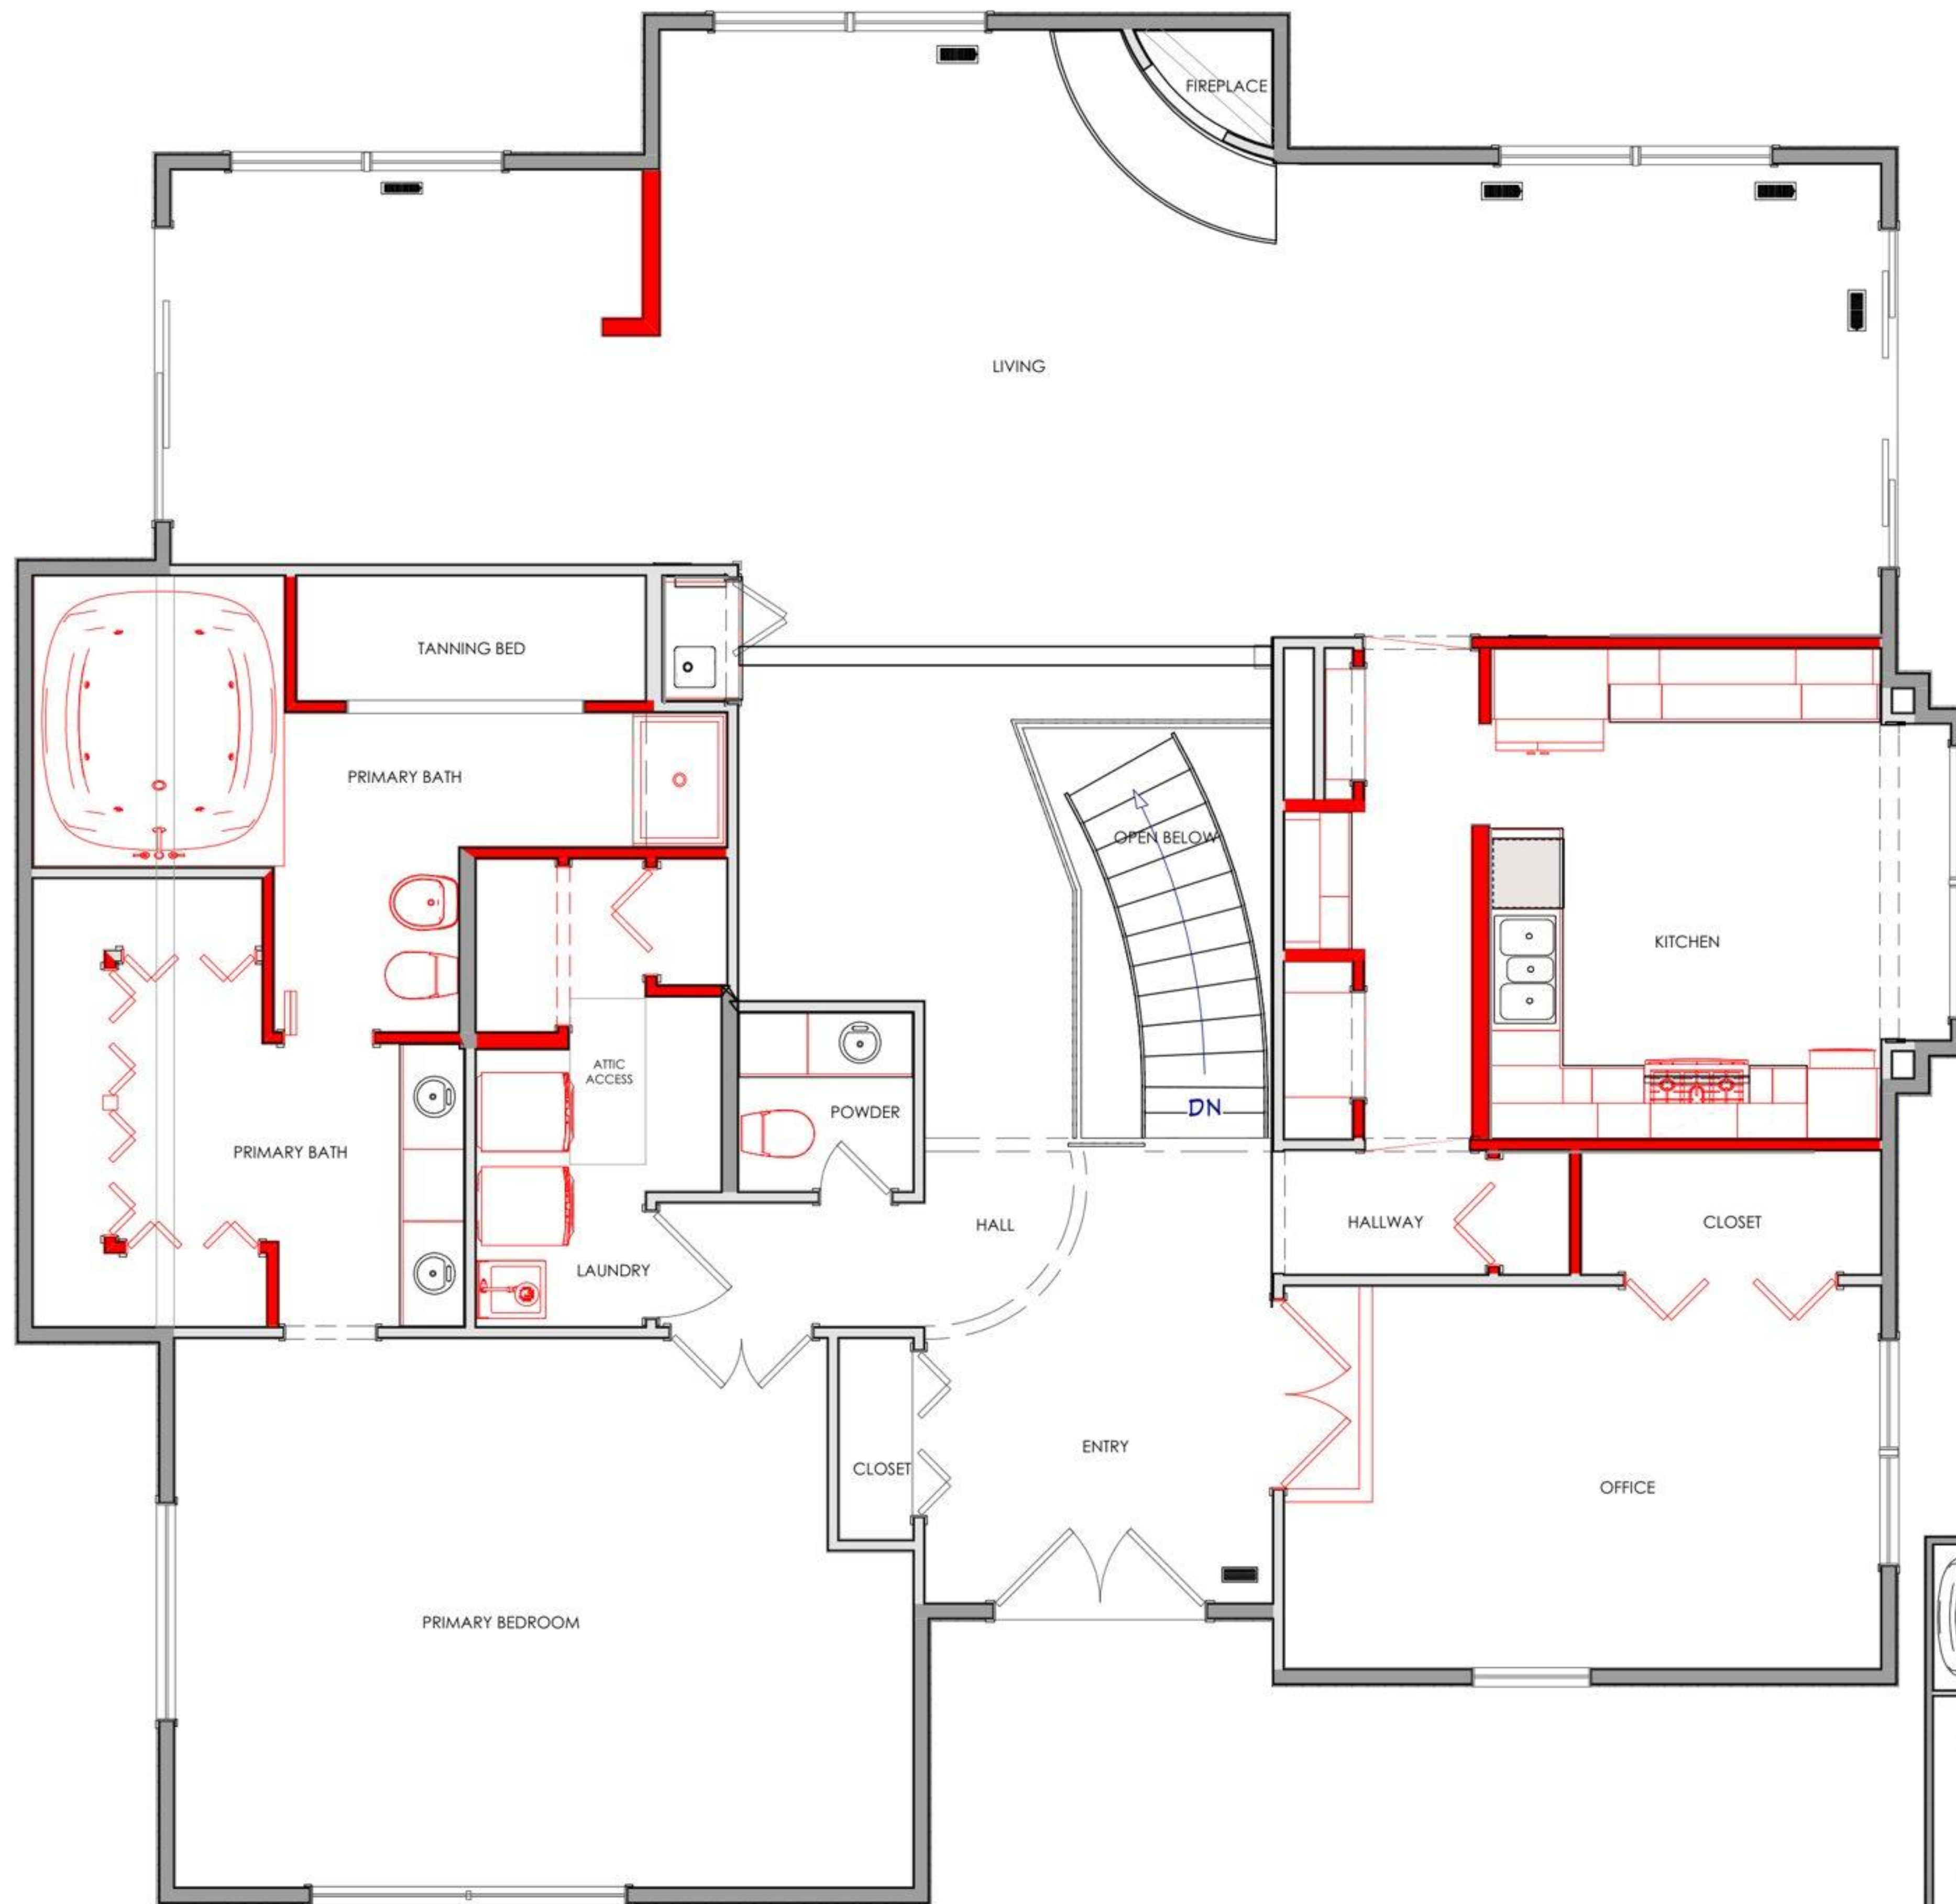

MAIN LEVEL DEMO PLAN

SCALE: 1/4" = 1' - 0"

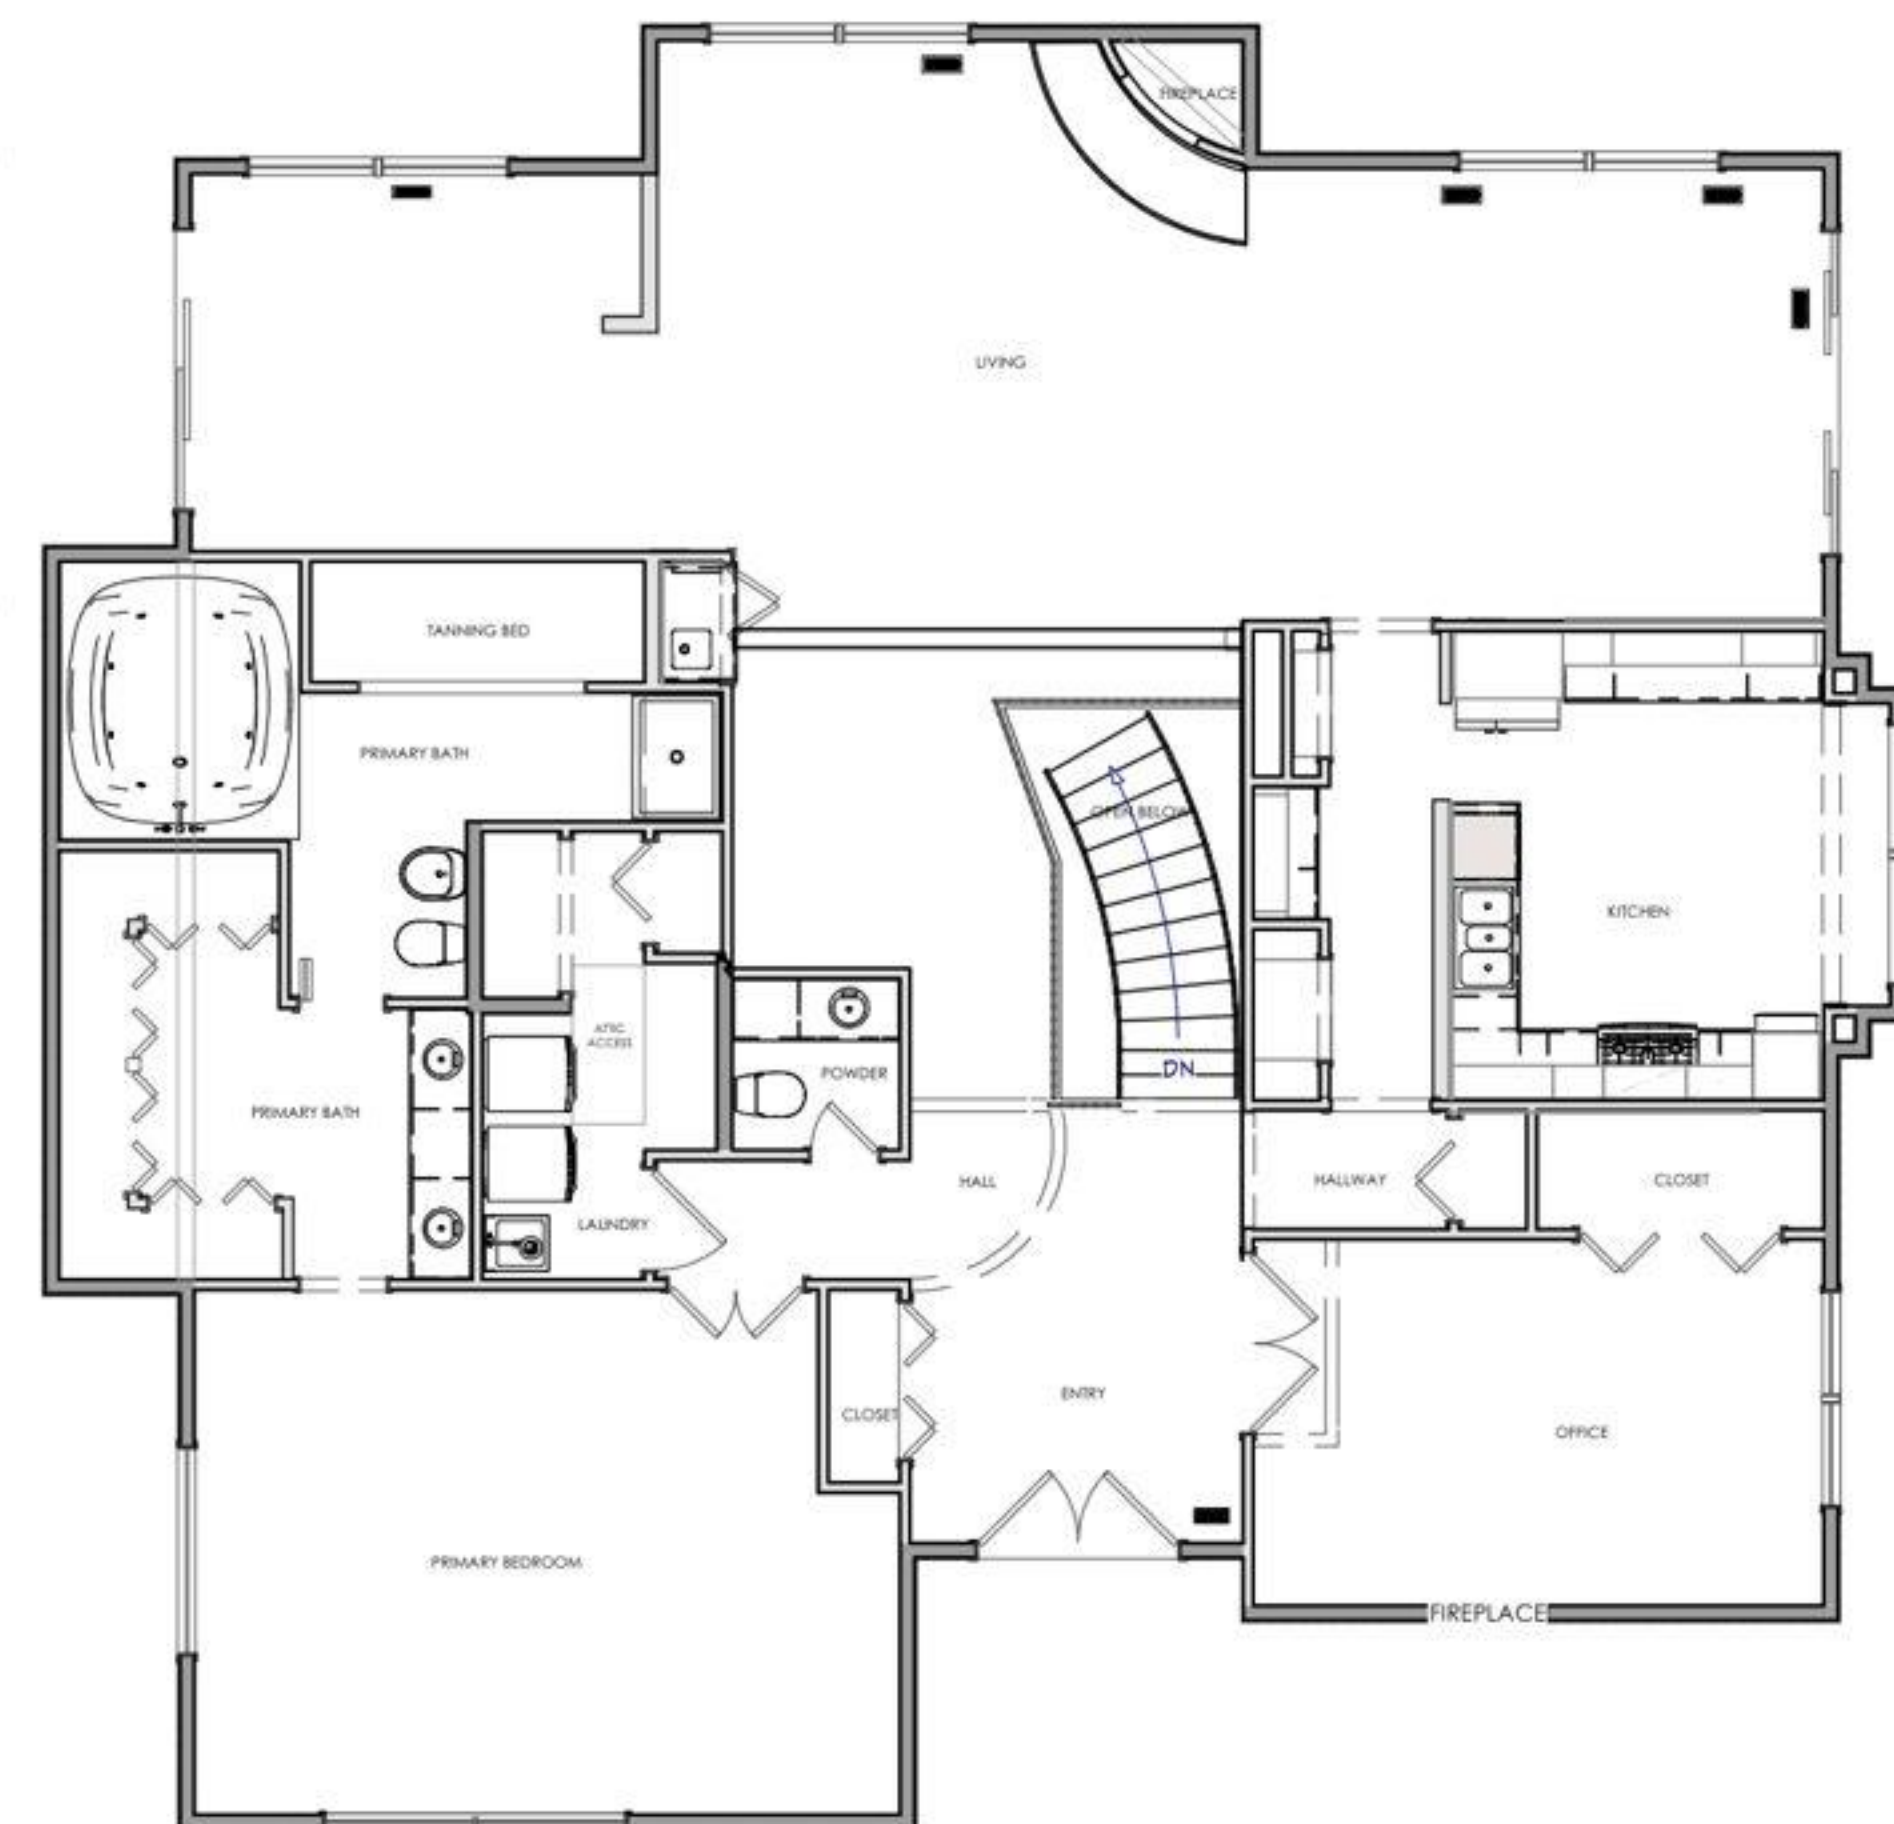

MAIN LEVEL AS-BUILT

SCALE: 1/8" = 1' - 0"



## CONSTRUCTION NOTES

**C1:** RELOCATE/ENLARGE DOOR TO OFFICE 60"W X 80"H

**C2:** INTERIOR WINDOW AT OFFICE OVER DOOR, MATCH DOOR WIDTH, FOLLOW PITCH OF CEILING. TOTAL HEIGHT 60"

**C3:** FRAME DESK NOOK AT OFFICE: 110"W X 21"D X 84" H

**C4:** FRAME NEW PLATFORM AT OFFICE: 83" X 36" X 6"H, WITH RADIUS CORNER

**C5:** (2) NEW WINDOWS AT KITCHEN 21"W X 52" H X 42" AFF

**C6:** FRAME NOOK FOR REFRIGERATOR/PANTRY CABINETS AT KITCHEN: 168"W X 13.5"D X 111"H

**C7:** FRAME NOOK FOR CABINETS AT KITCHEN: 118"W X 25.5"D X 99" H

**C8:** CAP FLOOR DRAIN AT LAUNDRY

**C9:** FRAME NEW CLOSET AT PRIMARY BEDROOM WITH 72" WIDE DOORS

**C10:** FRAME FOR NEW POCKET DOOR AT PRIMARY BATH: 30"W X 80"H

**C11:** FRAME FOR NEW DOOR AT WATER CLOSET: 24"W X 80"H

**C12:** FRAME 6" PLATFORM FOR WET ROOM AT PRIMARY BATH

**C13:** FRAME HALF WALL/LEDGE AT WET ROOM EXTERIOR WALL: 46.5"H x 5.5" D

**C14:** FRAME (2) HALF WALLS BETWEEN WET ROOM AND VANITY AREA: 47.5"H

**C15:** FRAME HALF WALL/LEDGE BEHIND VANITY: 46.5"H


**C16:** NEW WINDOW AT PRIMARY BATH: 72"W X 24" H X 72" AFF

**C17:** FRAME CEILING OF RANGE NOOK IN KITCHEN TO BE FLUSH WITH BEAM: 100" AFF

**C18:** ADD INSULATION AT PRIMARY CLOSET/BATH WALLS & FLOOR AT CANTILEVERED AREAS

**\* CONTRACTOR TO PROVIDE AND INSTALL ALL NEW WINDOWS, DOORS, TRIM**

**\* DIMENSIONS ARE TO DRYWALL FINISH**

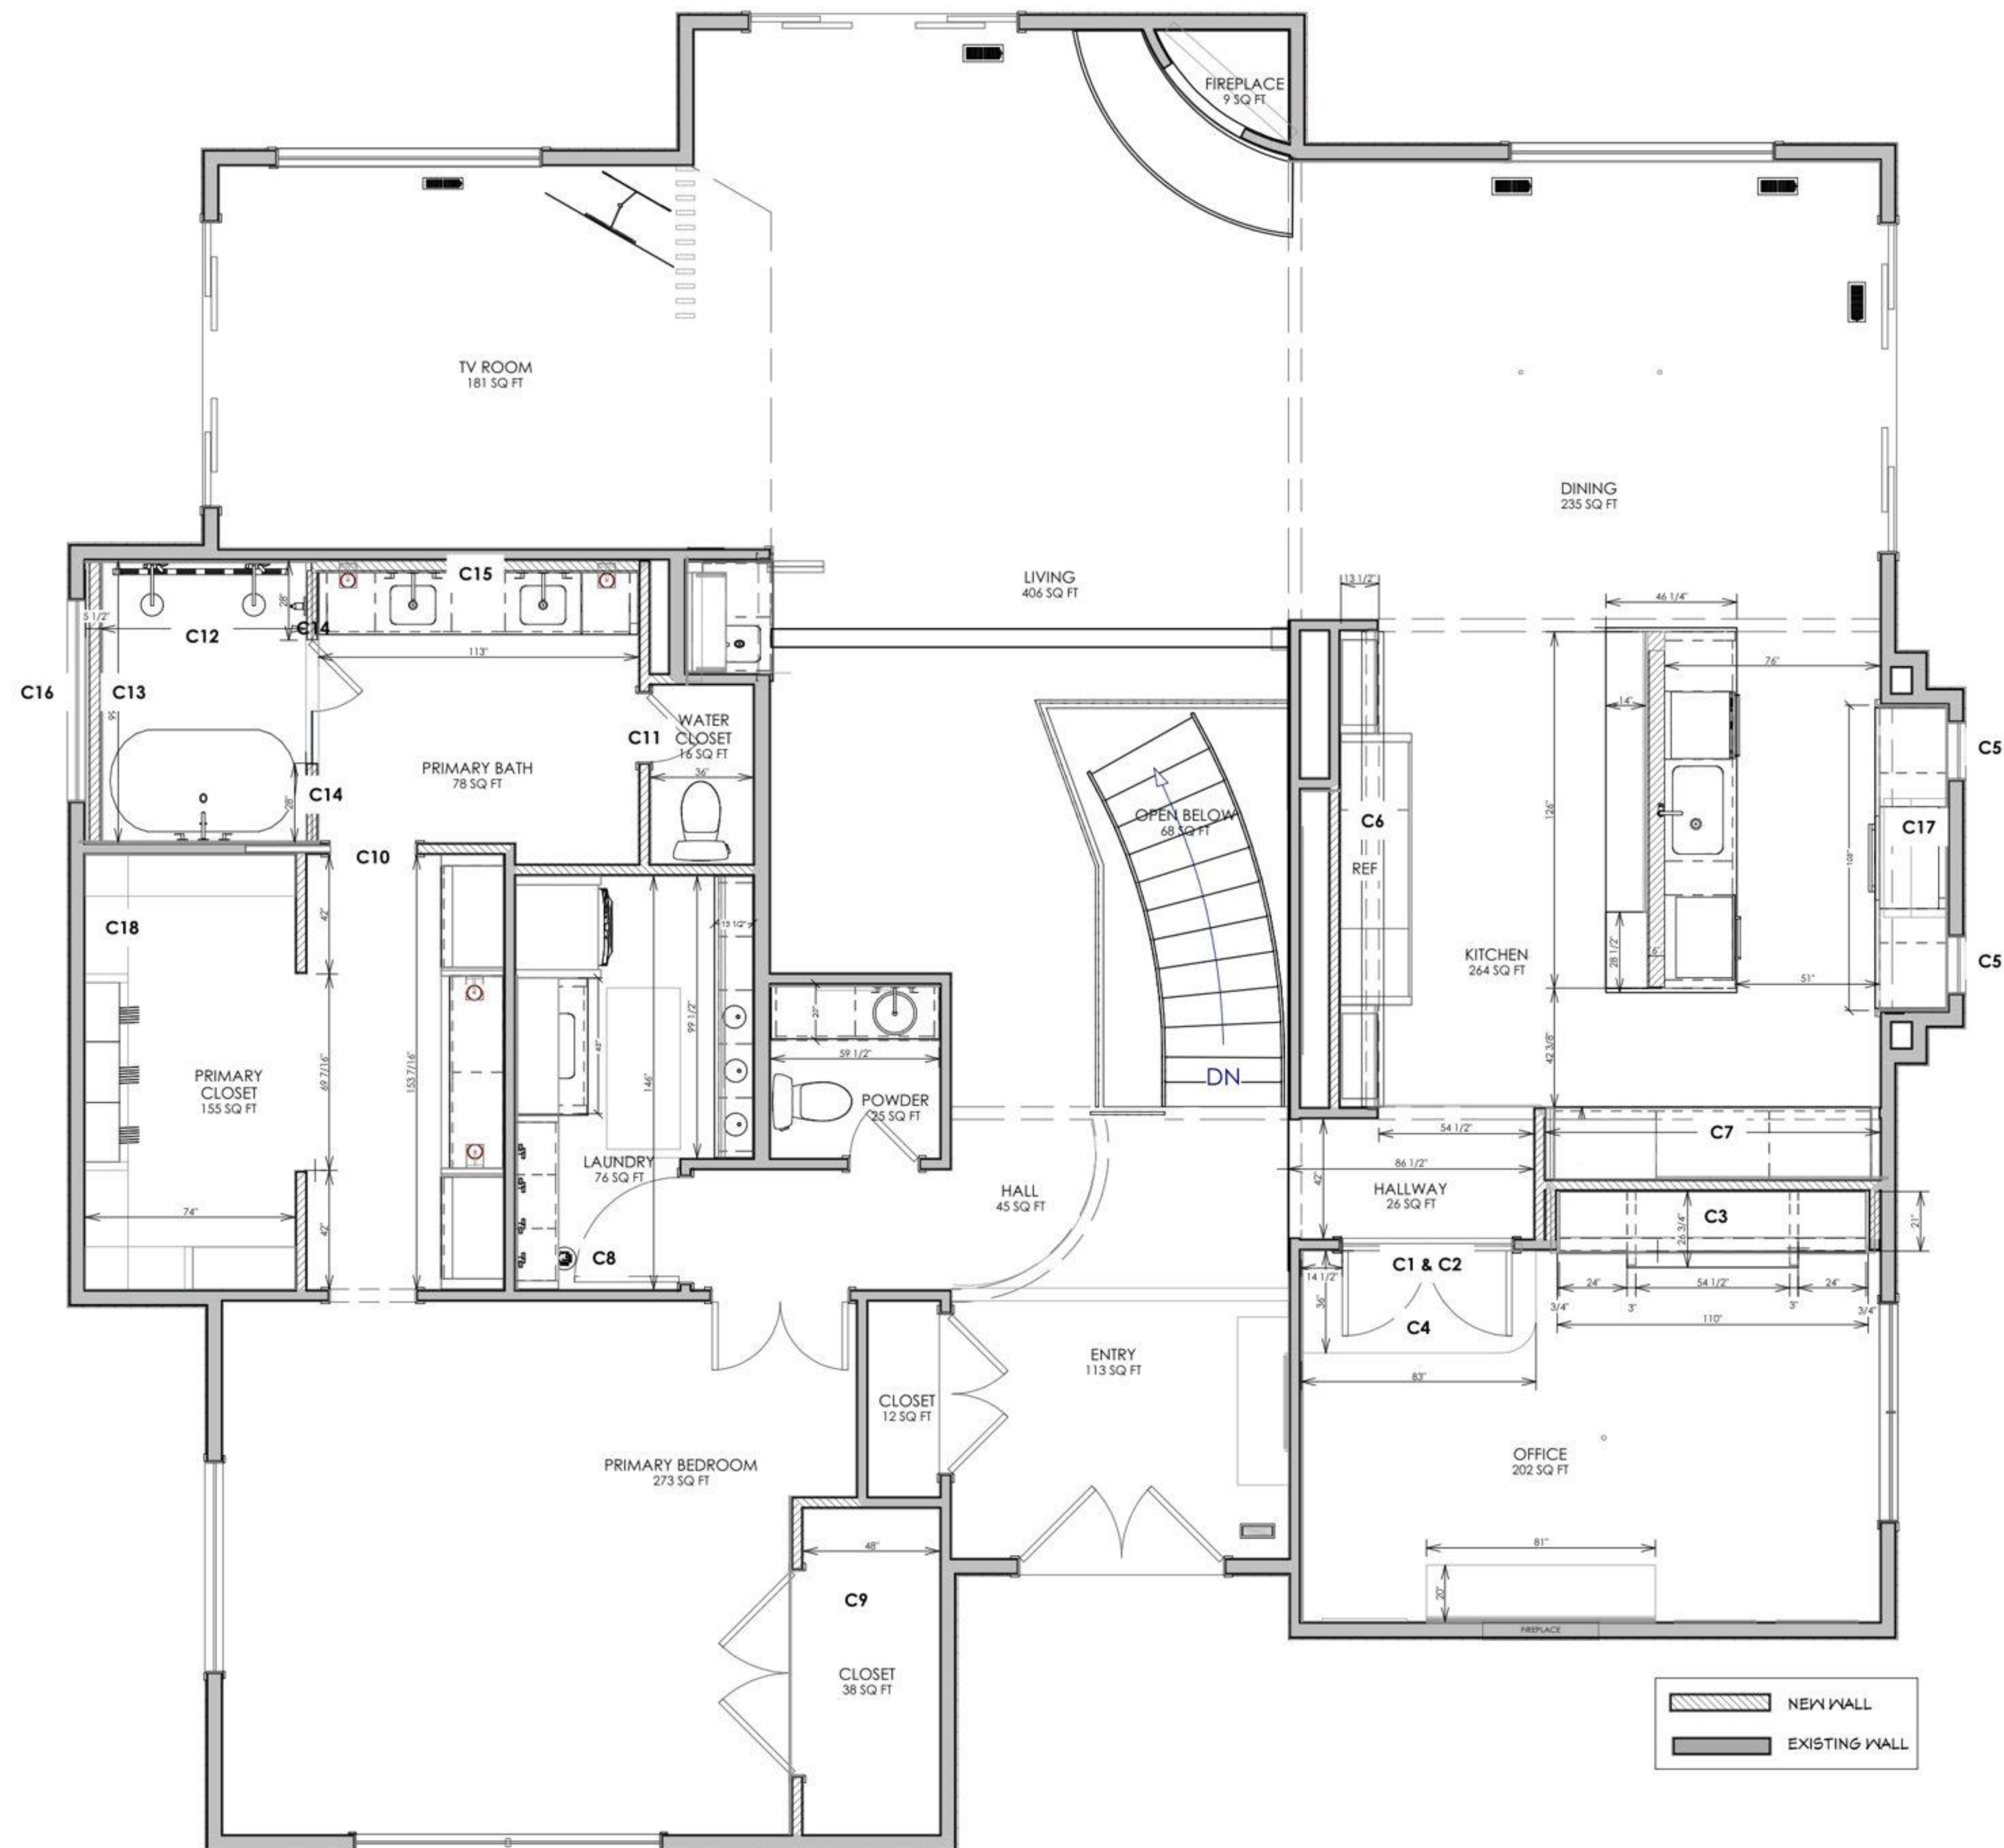

## MAIN LEVEL NEW DESIGN

SCALE: 1/4" = 1' - 0"

## MAIN FLOOR REMODEL


5/21/2025  
date

1/4" = 1' - 0"  
scale

2  
page

ELECTRICAL NOTES

- \* ALL SWITCHES TO HAVE DIMMERS
- \* REFER TO APPLIANCE SPECS FOR ELECTRICAL REQUIREMENTS
- \* INSTALL 4" LED RECESSED CANS
- \* INSTALL PUCK LIGHTS IN KITCHEN AT WALL CABINET AREAS
- \* INSTALL OUTLETS PER CODE
- \* INSTALL (2) "HIDDEN" OUTLETS AT KITCHEN ISLAND
- \* ADD ELECTRICAL FOR CHARGING DRAWER AT KITCHEN ISLAND (18" TRASH CABINET)
- \* EX- DENOTES EXISTING LOCATION TO REMAIN

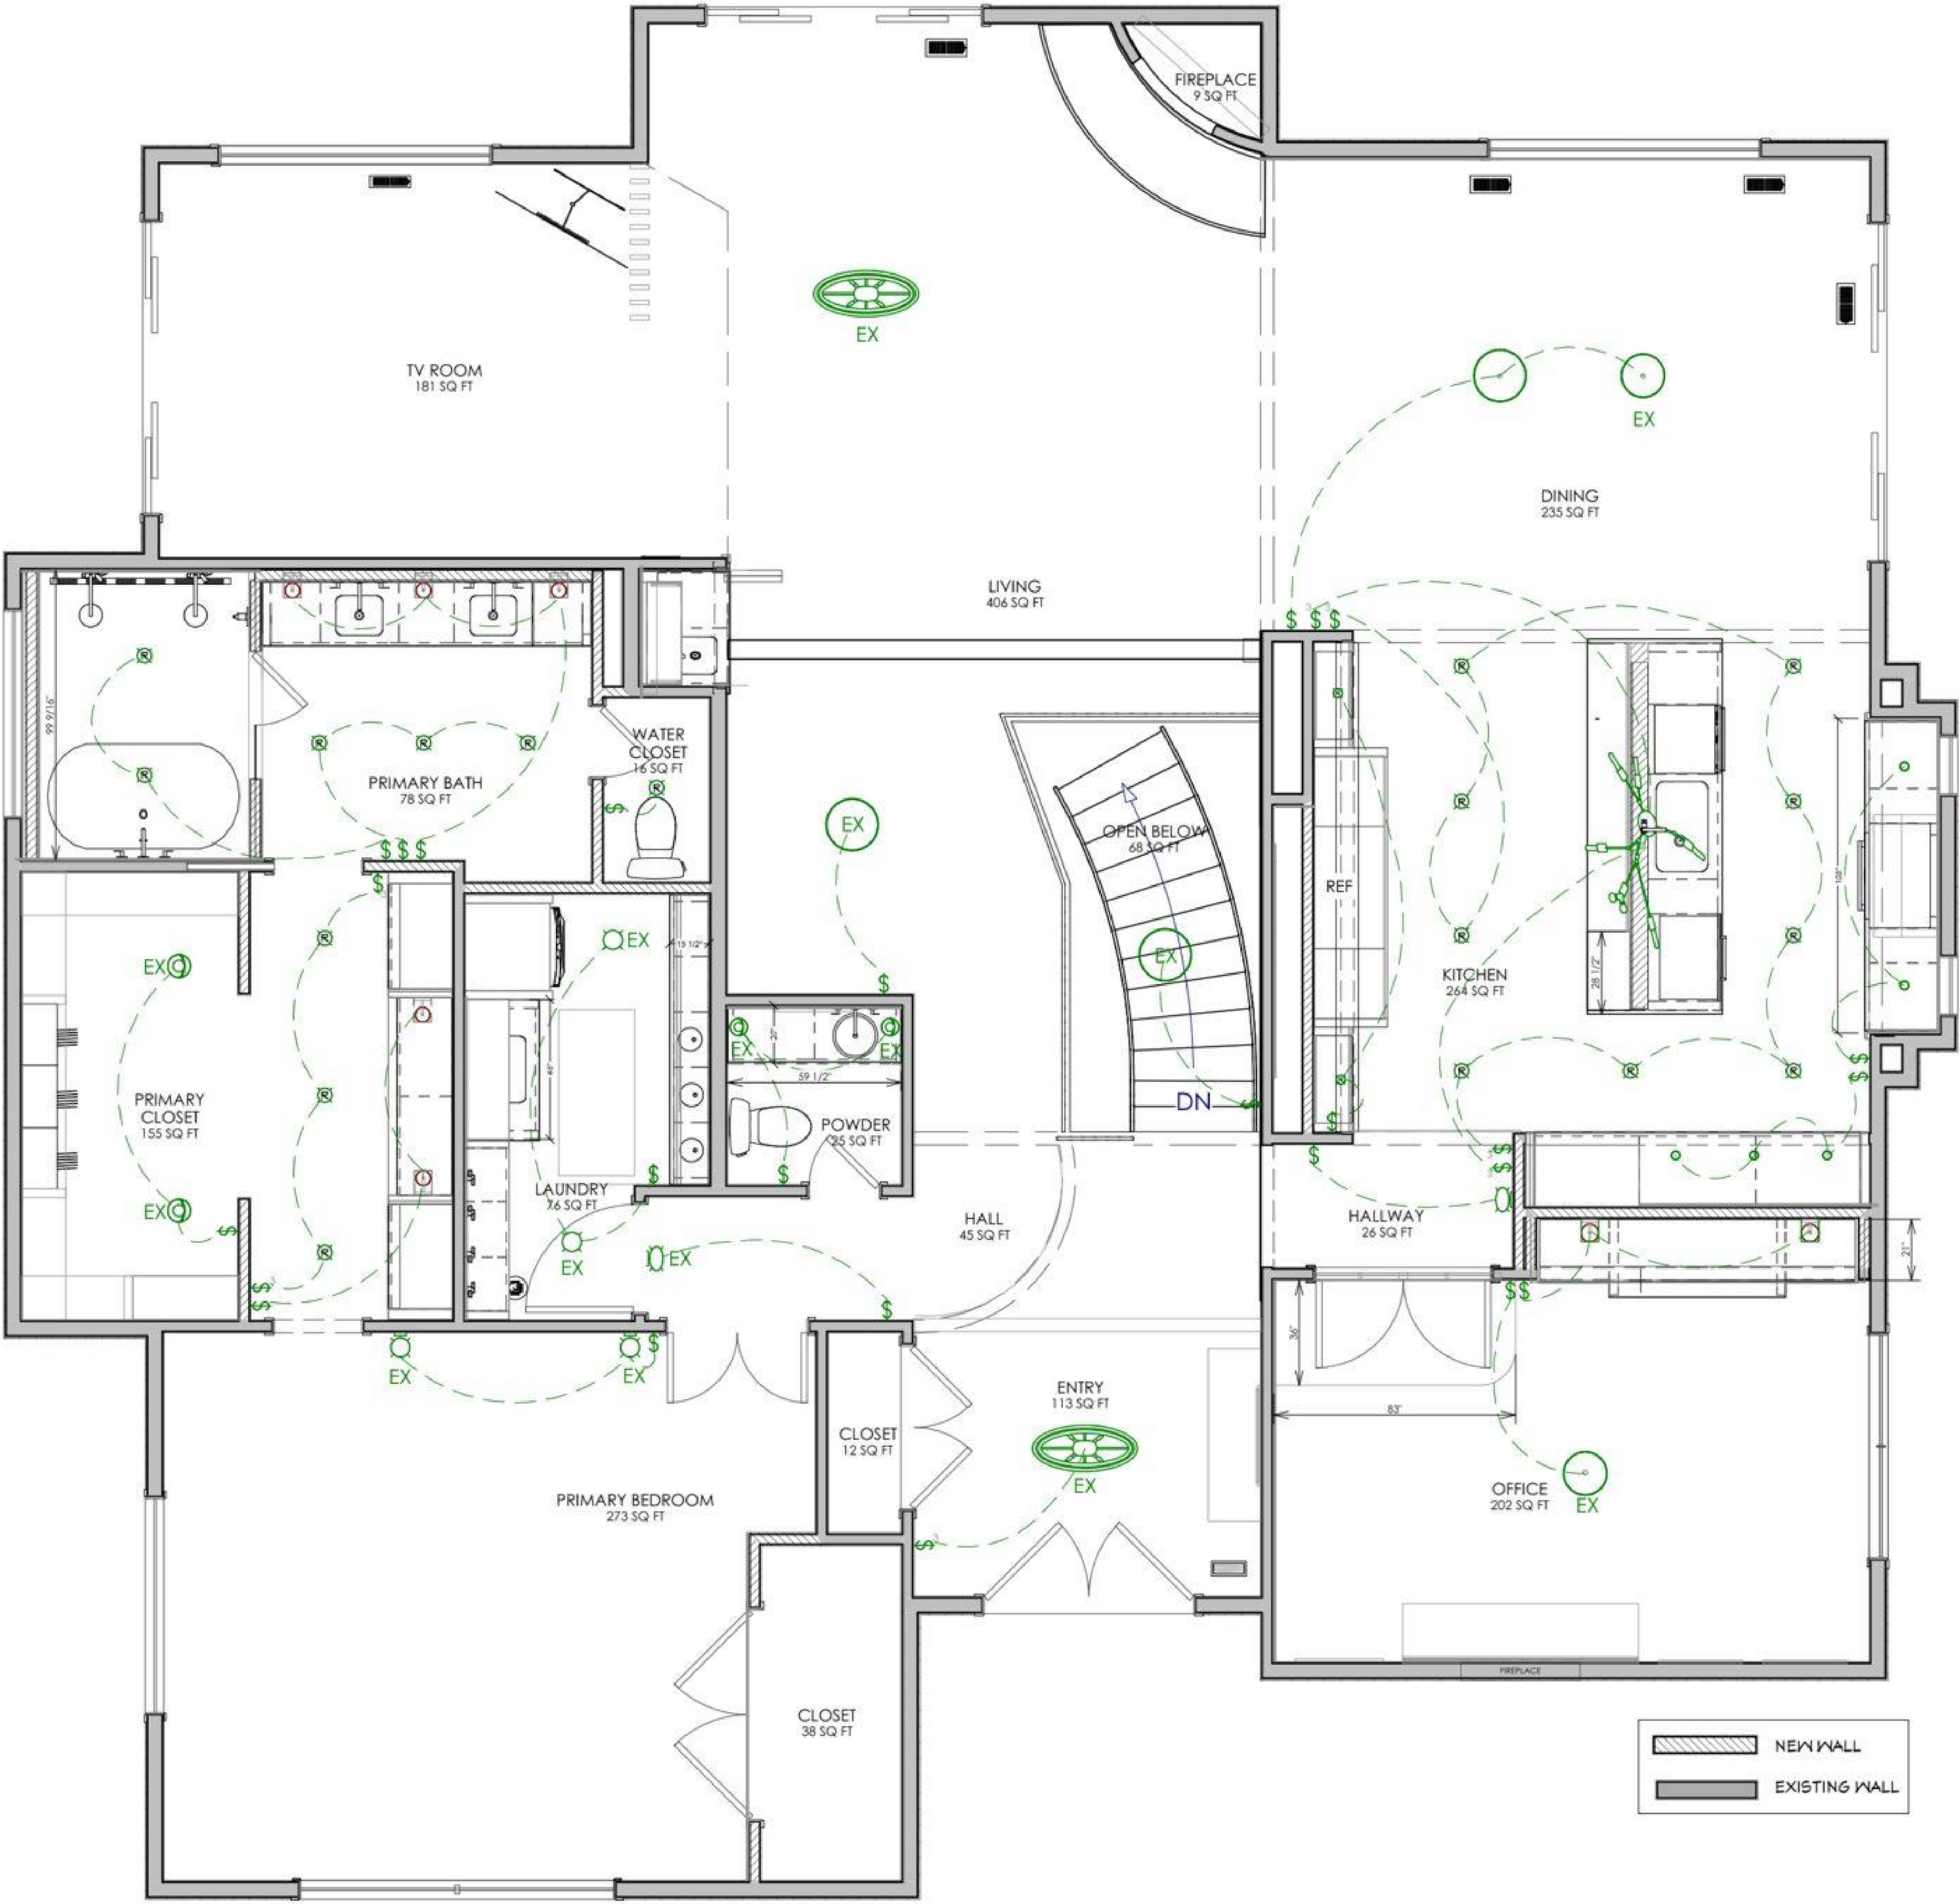

MAIN LEVEL ELECTRICAL PLAN

SCALE: 1/4" = 1' - 0"



5/21/2025  
date


1/4" = 1' - 0"  
scale



3  
page



KITCHEN: HICKORY EBONY

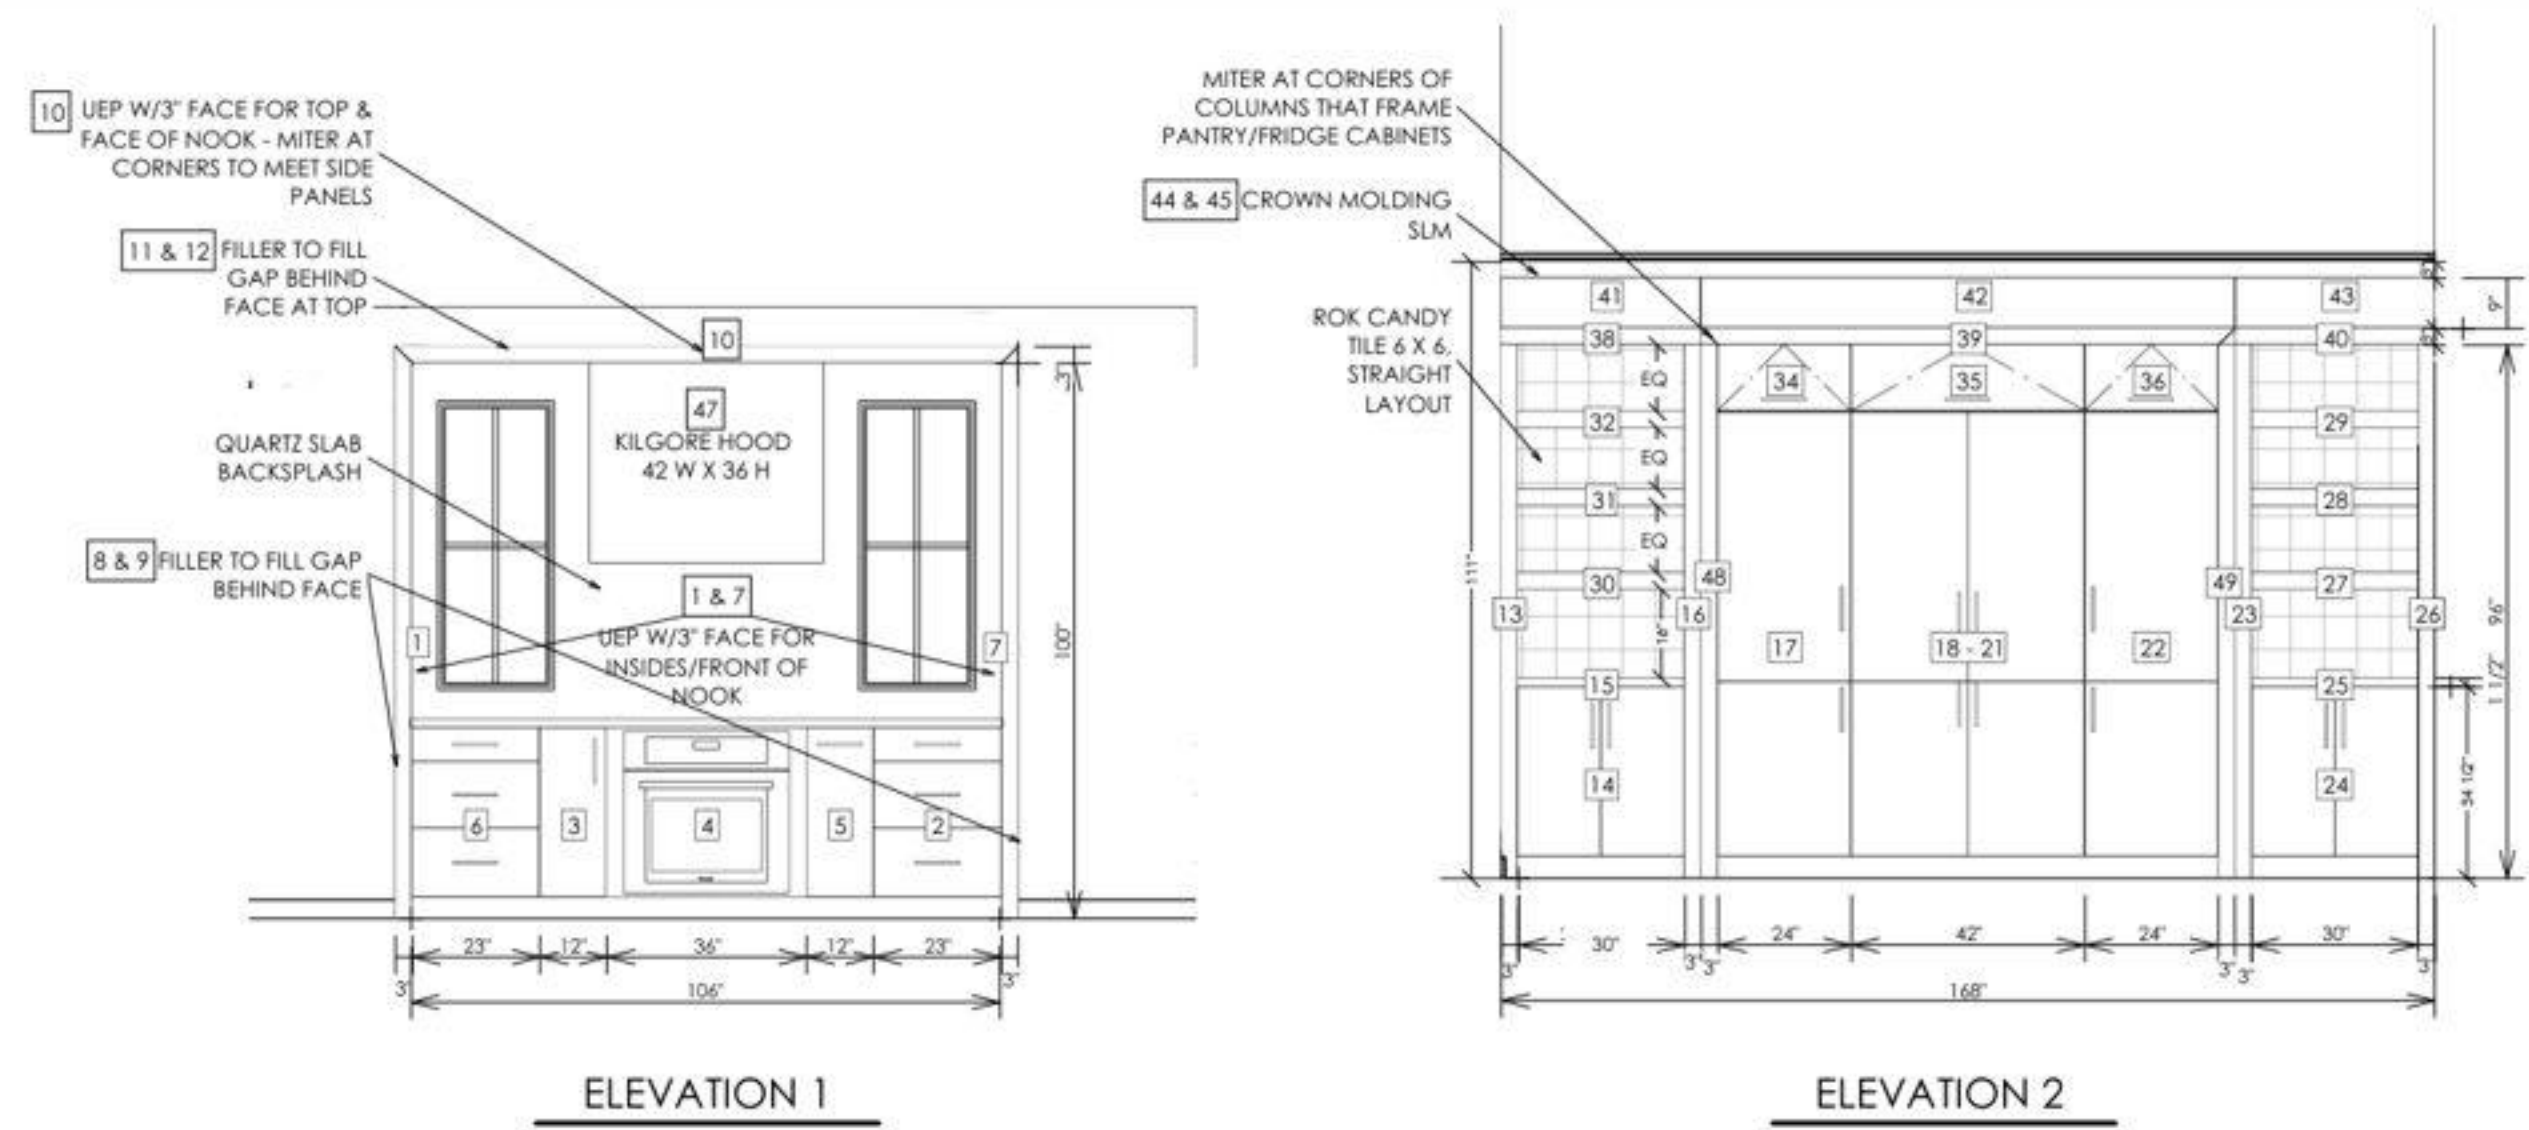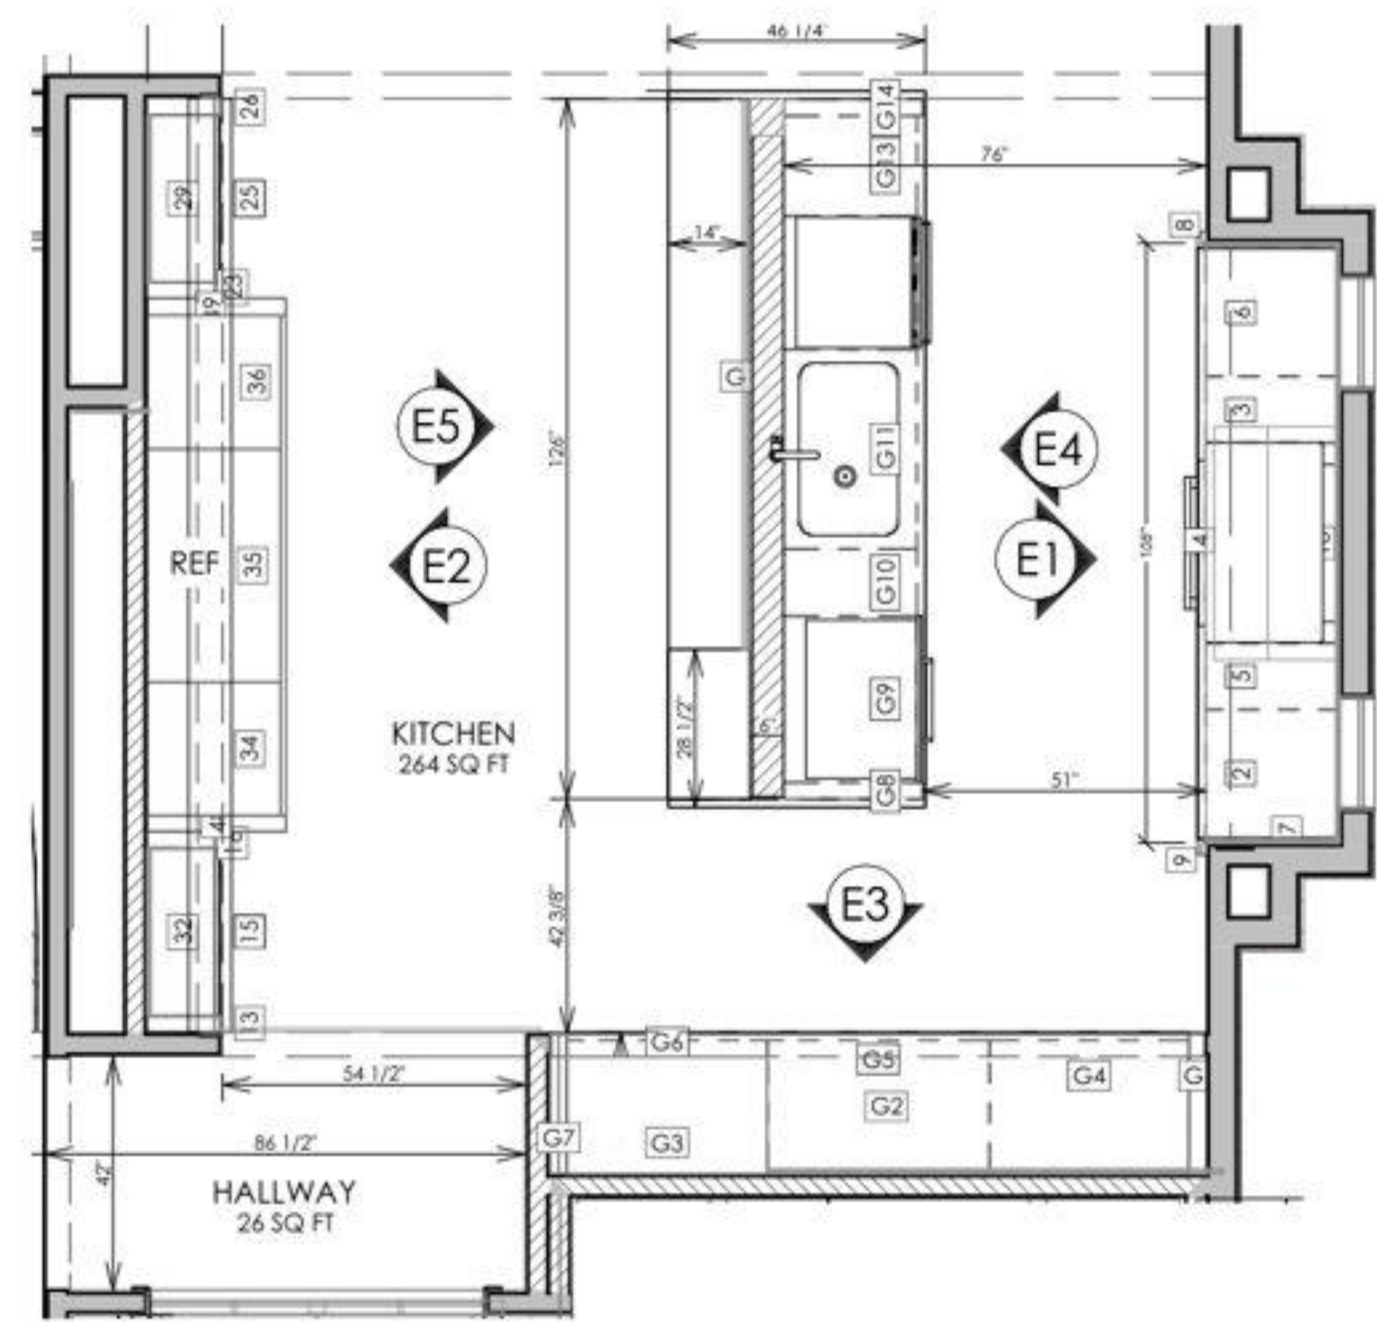




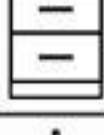
| ELEVATION 1 ▾                                                                       |                 | CABINET SCHEDULE: EBONY STAIN |         |         |         |                                                                                         |
|-------------------------------------------------------------------------------------|-----------------|-------------------------------|---------|---------|---------|-----------------------------------------------------------------------------------------|
| NO                                                                                  | ELEVATION LABEL | QTY                           | WIDTH   | HEIGHT  | DEPTH   | DESCRIPTION                                                                             |
|    | 1               | 1                             | 3"      | 100"    | 25 1/2" | UEP W/3" FACE AT SIDES OF NOOK - NO TOE NOTCH - TRIM TO FIT - ORDER 30 X 120            |
|    | 2               | 1                             | 23"     | 34 1/2" | 24"     | 3 DRAWER BASE - SPICE INSERT AT TOP DRAWER                                              |
|    | 3               | 1                             | 12"     | 34 1/2" | 24"     | FULL HEIGHT DOOR BASE - TRAY DIVIDERS                                                   |
|   | 4               | 1                             | 36"     | 34 1/2" | 24"     | BASE FOR COOKTOP AND BUILT-IN OVEN - SEE APPLIANCE SPECS - ADD OVERLAY                  |
|  | 5               | 1                             | 12"     | 34 1/2" | 24"     | UTENSIL PULL-OUT BASE - ADD UBOSC                                                       |
|  | 6               | 1                             | 23"     | 34 1/2" | 24"     | 3 DRAWER BASE - UTENSIL TRAY AT TOP DRAWER FROM REV-A-SHELF                             |
|  | 7               | 1                             | 3"      | 100"    | 25 1/2" | UEP W/3" FACE AT SIDES OF NOOK - NO TOE NOTCH - TRIM TO FIT - ORDER 30 X 120            |
|  | 8               | 1                             | 3/4"    | 100"    | 2"      | 3" FLAT FILLER TO FILL GAP - STACK BEHIND FACE AT WALL - TRIM TO FIT - ORDER (2) @ 102" |
|  | 9               | 1                             | 3/4"    | 100"    | 2"      | 3" FLAT FILLER TO FILL GAP - STACK BEHIND FACE AT WALL - TRIM TO FIT - ORDER (2) @ 102" |
|  | 10              | 1                             | 25 1/2" | 3"      | 112"    | UEP W/3" FACE AT TOP OF NOOK - NO TOE NOTCH - TRIM TO FIT - ORDER 30 X 120              |
|  | 11 & 12         | 1                             | 3/4"    | 3"      | 112"    | 3" FLAT FILLER TO FILL GAP - STACK BEHIND FACE AT TOP - ORDER (2) F372 - TRIM TO FIT    |
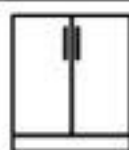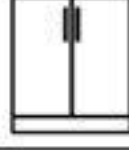
| ELEVATION 2                                                                           |                 | CABINET SCHEDULE: EBONY STAIN |       |         |       |                                                                                                       |
|---------------------------------------------------------------------------------------|-----------------|-------------------------------|-------|---------|-------|-------------------------------------------------------------------------------------------------------|
| NO                                                                                    | ELEVATION LABEL | QTY                           | WIDTH | HEIGHT  | DEPTH | DESCRIPTION                                                                                           |
|    | 13              | 1                             | 3"    | 96"     | 13"   | UEP W/6" FACE - NO TOE NOTCH<br>- TRIM FACE TO FIT                                                    |
|    | 14              | 1                             | 30"   | 34 1/2" | 12"   | SHALLOW BASE                                                                                          |
|    | 15              | 1                             | 30"   | 1 1/2"  | 13"   | PLYWOOD TOP CTP - PROFILE F                                                                           |
|   | 16              | 1                             | 3"    | 96"     | 13"   | 3" MITERED COLUMN                                                                                     |
|  | 17              | 1                             | 24"   | 84"     | 24"   | PANTRY - 1 ROLLOUT AT TOP<br>SECTION, 2 ROLLOUTS AT<br>BOTTOM - ALIGN DOOR HEIGHTS<br>W/FRIDGE PANELS |
|  | 18 - 21         | 1                             | 42"   | 84"     | 24"   | REFRIGERATOR PANELS - SEE<br>APPLIANCE SPECS                                                          |
|  | 22              | 1                             | 24"   | 84"     | 24"   | PANTRY - 1 ROLLOUT AT TOP<br>SECTION, 2 ROLLOUTS AT<br>BOTTOM - ALIGN DOOR HEIGHTS<br>W/FRIDGE PANELS |
|  | 23              | 1                             | 3"    | 96"     | 13"   | 3" MITERED COLUMN                                                                                     |
|  | 24              | 1                             | 30"   | 34 1/2" | 12"   | SHALLOW BASE                                                                                          |
|  | 25              | 1                             | 30"   | 1 1/2"  | 13"   | PLYWOOD TOP CTP - PROFILE F                                                                           |
|  | 26              | 1                             | 3"    | 96"     | 13"   | UEP W/6" FACE - NO TOE NOTCH<br>- TRIM FACE TO FIT                                                    |
|  | 27              | 1                             | 30"   | 3"      | 12"   | 3" MITERED COLUMNS FOR<br>FLOATING SHELVES                                                            |
|  | 28              | 1                             | 30"   | 3"      | 12"   | 3" MITERED COLUMNS FOR<br>FLOATING SHELVES                                                            |
|  | 29              | 1                             | 30"   | 3"      | 12"   | 3" MITERED COLUMNS FOR<br>FLOATING SHELVES                                                            |

| ELEVATION 2 |                 | CABINET SCHEDULE: EBONY STAIN |       |        |       |                                                                     |
|-------------|-----------------|-------------------------------|-------|--------|-------|---------------------------------------------------------------------|
| NO          | ELEVATION LABEL | QTY                           | WIDTH | HEIGHT | DEPTH | DESCRIPTION                                                         |
|             | 30              | 1                             | 30"   | 3"     | 12"   | 3" MITERED COLUMNS FOR FLOATING SHELVES                             |
|             | 31              | 1                             | 30"   | 3"     | 12"   | 3" MITERED COLUMNS FOR FLOATING SHELVES                             |
|             | 32              | 1                             | 30"   | 3"     | 12"   | 3" MITERED COLUMNS FOR FLOATING SHELVES                             |
|             | 34              | 1                             | 24"   | 12"    | 24"   | TOP HINGE WALL CABINET                                              |
|             | 35              | 1                             | 42"   | 12"    | 24"   | TOP HINGE WALL CABINET                                              |
|             | 36              | 1                             | 24"   | 12"    | 24"   | TOP HINGE WALL CABINET                                              |
|             | 38              | 1                             | 36"   | 3"     | 13"   | 3" MITERED COLUMN - TOP FOR BOOKCASE - TRIM TO FIT - ORDER 42" LONG |
|             | 39              | 1                             | 96"   | 3"     | 25"   | 3" MITERED COLUMNS - TOP FOR PANTRY'S / FRIDGE                      |
|             | 40              | 1                             | 36"   | 3"     | 13"   | 3" MITERED COLUMN - TOP FOR BOOKCASE - TRIM TO FIT - ORDER 42" LONG |
|             | 41              | 1                             | 36"   | 9"     | 12"   | 3/4" PANEL - TRIM TO FIT - ORDER 42" LONG                           |
|             | 42              | 1                             | 96"   | 9"     | 12"   | 3/4" PANEL                                                          |
|             | 43              | 1                             | 36"   | 9"     | 12"   | 3/4" PANEL - TRIM TO FIT - ORDER 42" LONG                           |
|             | 48              | 1                             | 3"    | 99"    | 25"   | 3" MITERED COLUMN                                                   |
|             | 49              | 1                             | 3"    | 99"    | 25"   | 3" MITERED COLUMN                                                   |



**KITCHEN: WALNUT WARM GREY**

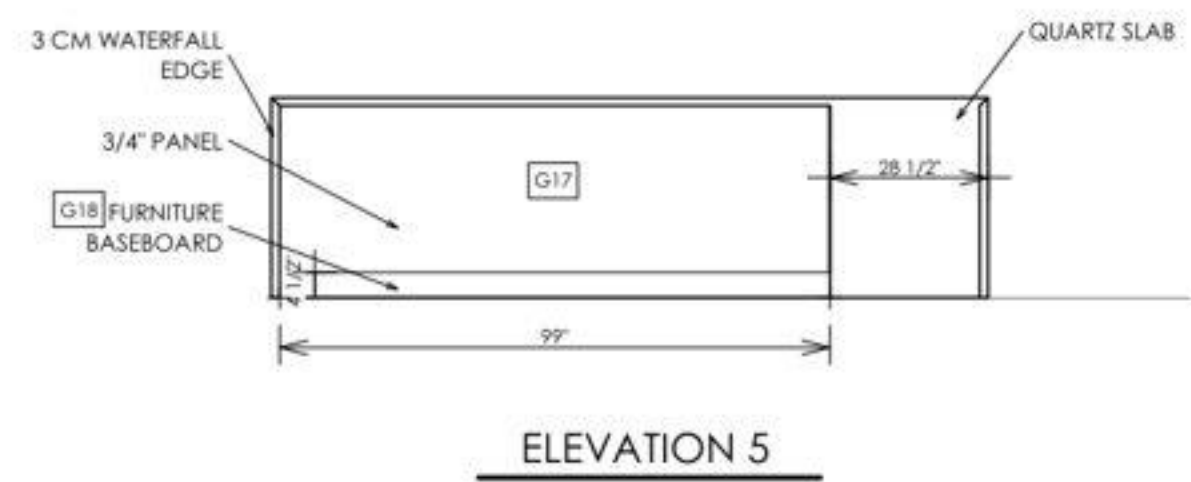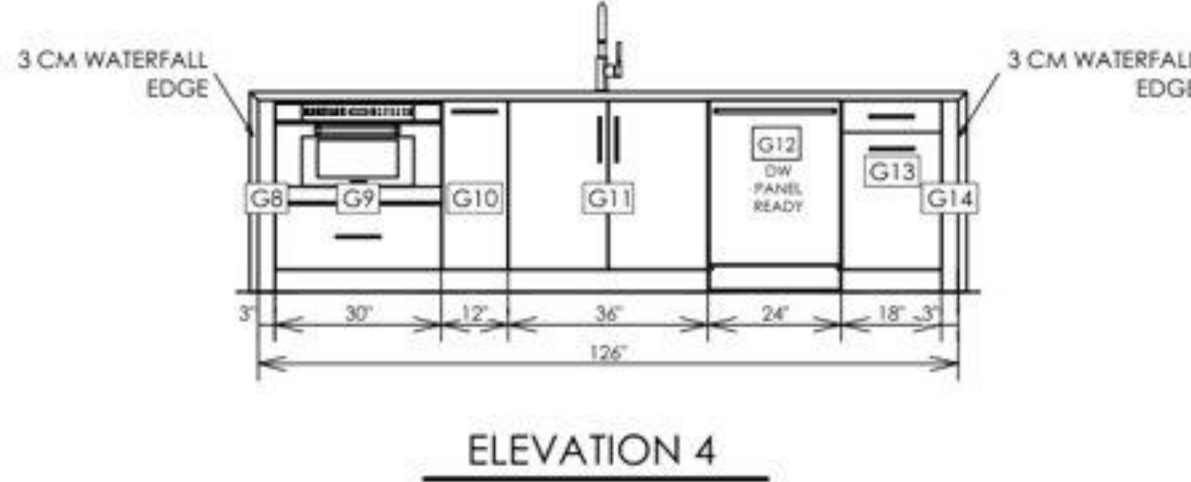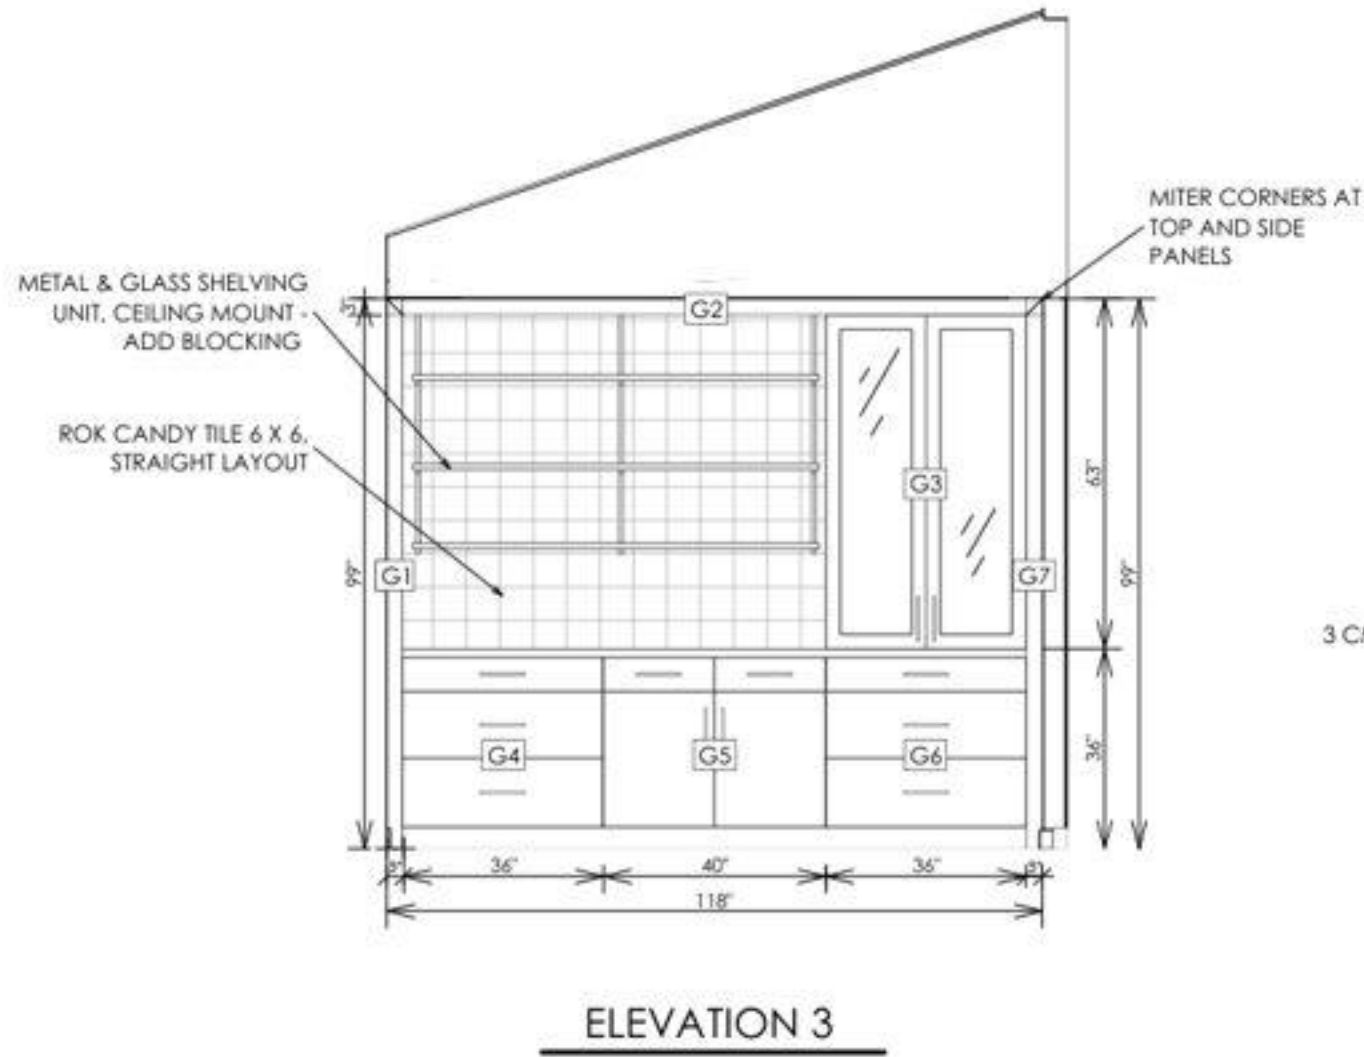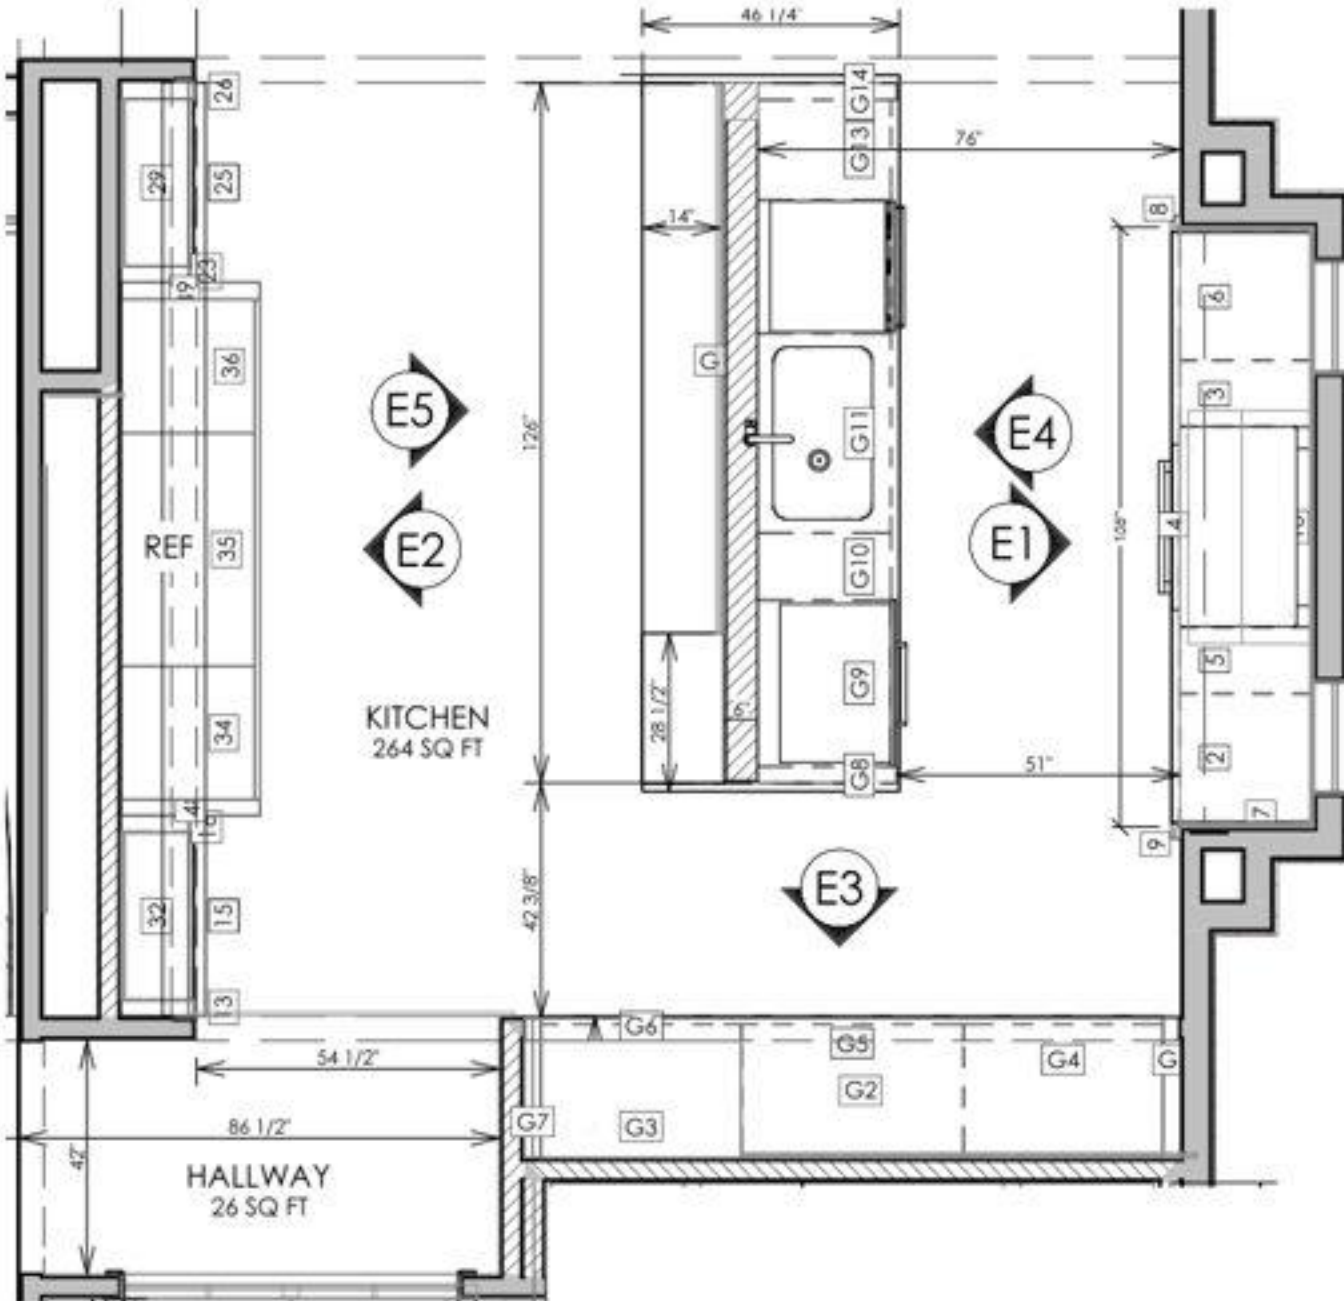

| EL. 3, 4, 5 ▼                                                                         |       | CABINET SCHEDULE: WALNUT W/WARM GREY STAIN |       |         |       |                                                                                     |
|---------------------------------------------------------------------------------------|-------|--------------------------------------------|-------|---------|-------|-------------------------------------------------------------------------------------|
| ISO ELEVATION                                                                         | LABEL | QTY                                        | WIDTH | HEIGHT  | DEPTH | DESCRIPTION                                                                         |
|    | G1    | 1                                          | 3"    | 99"     | 25"   | UEP W/3" FACE - NO TOE NOTCH - ORDER 99"                                            |
|   | G2    | 1                                          | 118"  | 3"      | 25"   | UEP W/ 3" FACE - NO TOE NOTCH - TRIM TO FIT - ORDER 120" LONG                       |
|  | G3    | 1                                          | 36"   | 60"     | 21"   | POCKET DOORS - ELEMENTS GLASS DOORS AF011 (THIN REEDED GLASS - NO BOTTOM ON CABINET |
|  | G4    | 1                                          | 36"   | 34 1/2" | 24"   | 3 DRAWER BASE - CUTLERY AT TOP DRAWER FROM REV-A-SHELF                              |
|  | G5    | 1                                          | 40"   | 34 1/2" | 24"   | 2 ROLL-OUTS EACH SIDE                                                               |
|  | G6    | 1                                          | 36"   | 34 1/2" | 24"   | BASE CABINET                                                                        |
|  | G7    | 1                                          | 3"    | 99"     | 25"   | UEP W/3" FACE - NO TOE NOTCH - ORDER 99"                                            |
|  | G8    | 1                                          | 3"    | 34 1/2" | 25"   | 3" MITERED COLUMN                                                                   |
|  | G9    | 1                                          | 30"   | 34 1/2" | 24"   | MICROWAVE BASE CABINET - SEE APPLIANCE SPECS                                        |
|  | G10   | 1                                          | 12"   | 34 1/2" | 24"   | PULL - OUT: REV A SHELF PAPER TOWEL PULL-OUT                                        |
|  | G11   | 1                                          | 36"   | 34 1/2" | 24"   | SINK BASE - FULL HEIGHT DOORS                                                       |
|  | G13   | 1                                          | 18"   | 34 1/2" | 24"   | DOUBLE TRASH PULL-OUT: CHARGING DRAWER AT TOP                                       |
|  | G14   | 1                                          | 3"    | 34 1/2" | 25"   | 3" MITERED COLUMN                                                                   |
|  | G17   | 1                                          | 3/4"  | 34 1/2" | 99"   | 3/4" PANEL AT BACK OF ISLAND                                                        |

## MAIN FLOOR REMODEL

5/20/2025  
date




$$\frac{1/4" = 1' - 0"}{\text{scale}}$$


5  
page



## VERSATILE DESIGN



OFFICE: HICKORY EBONY

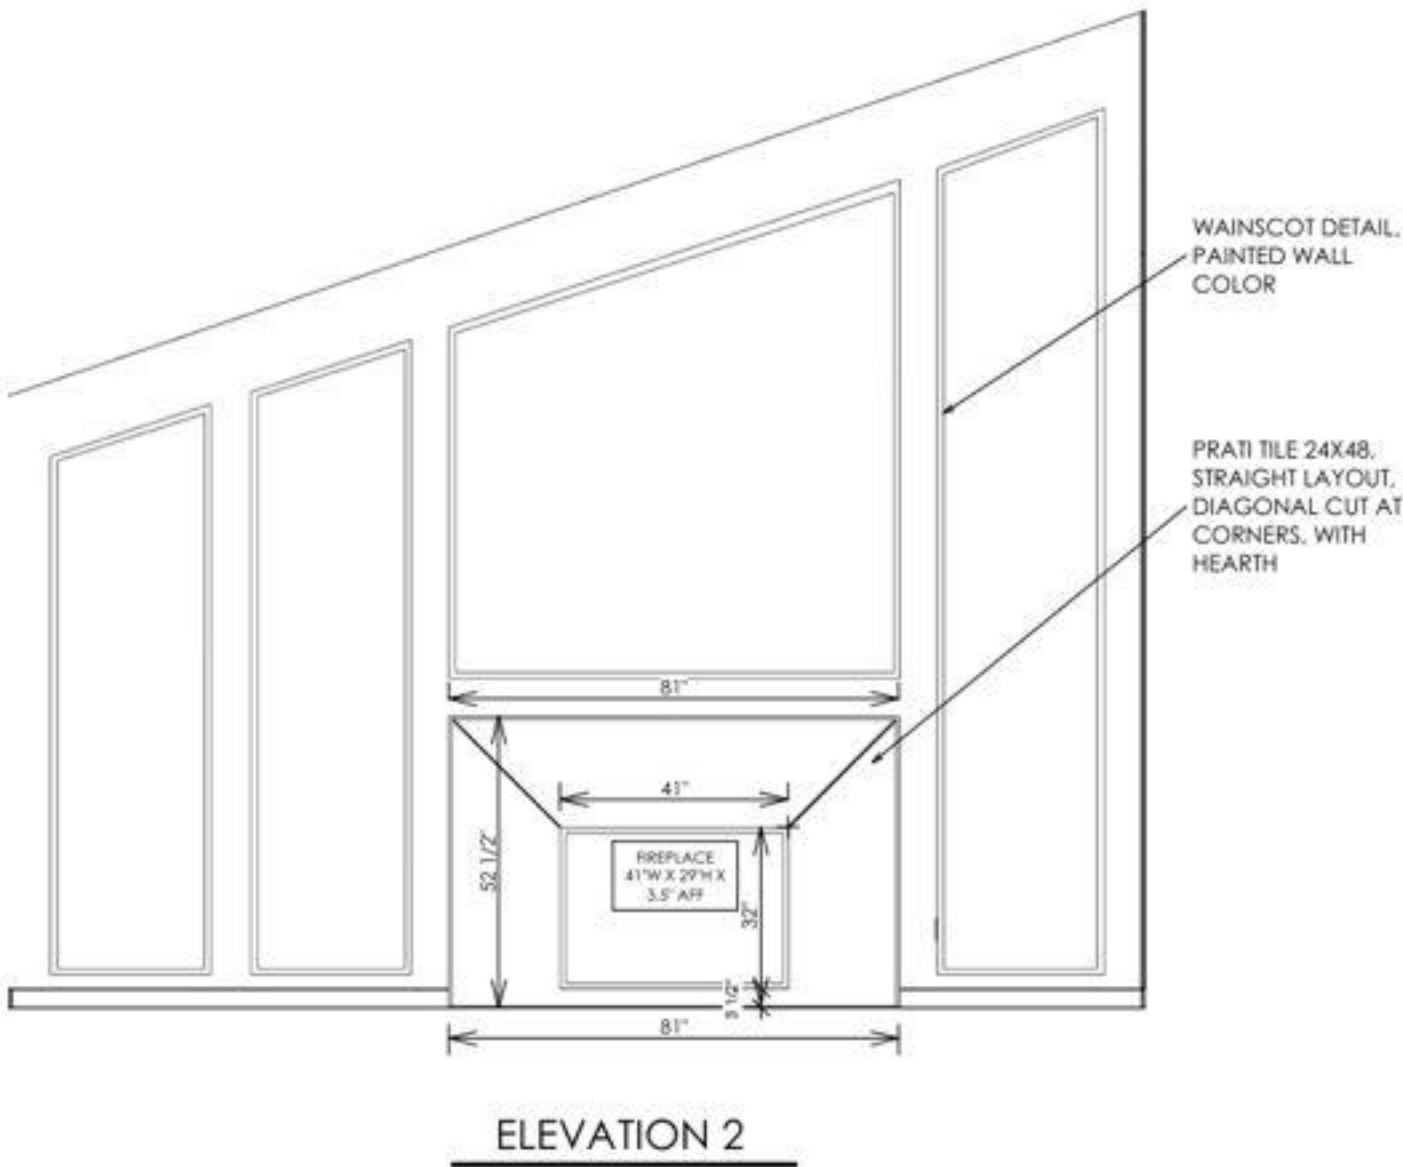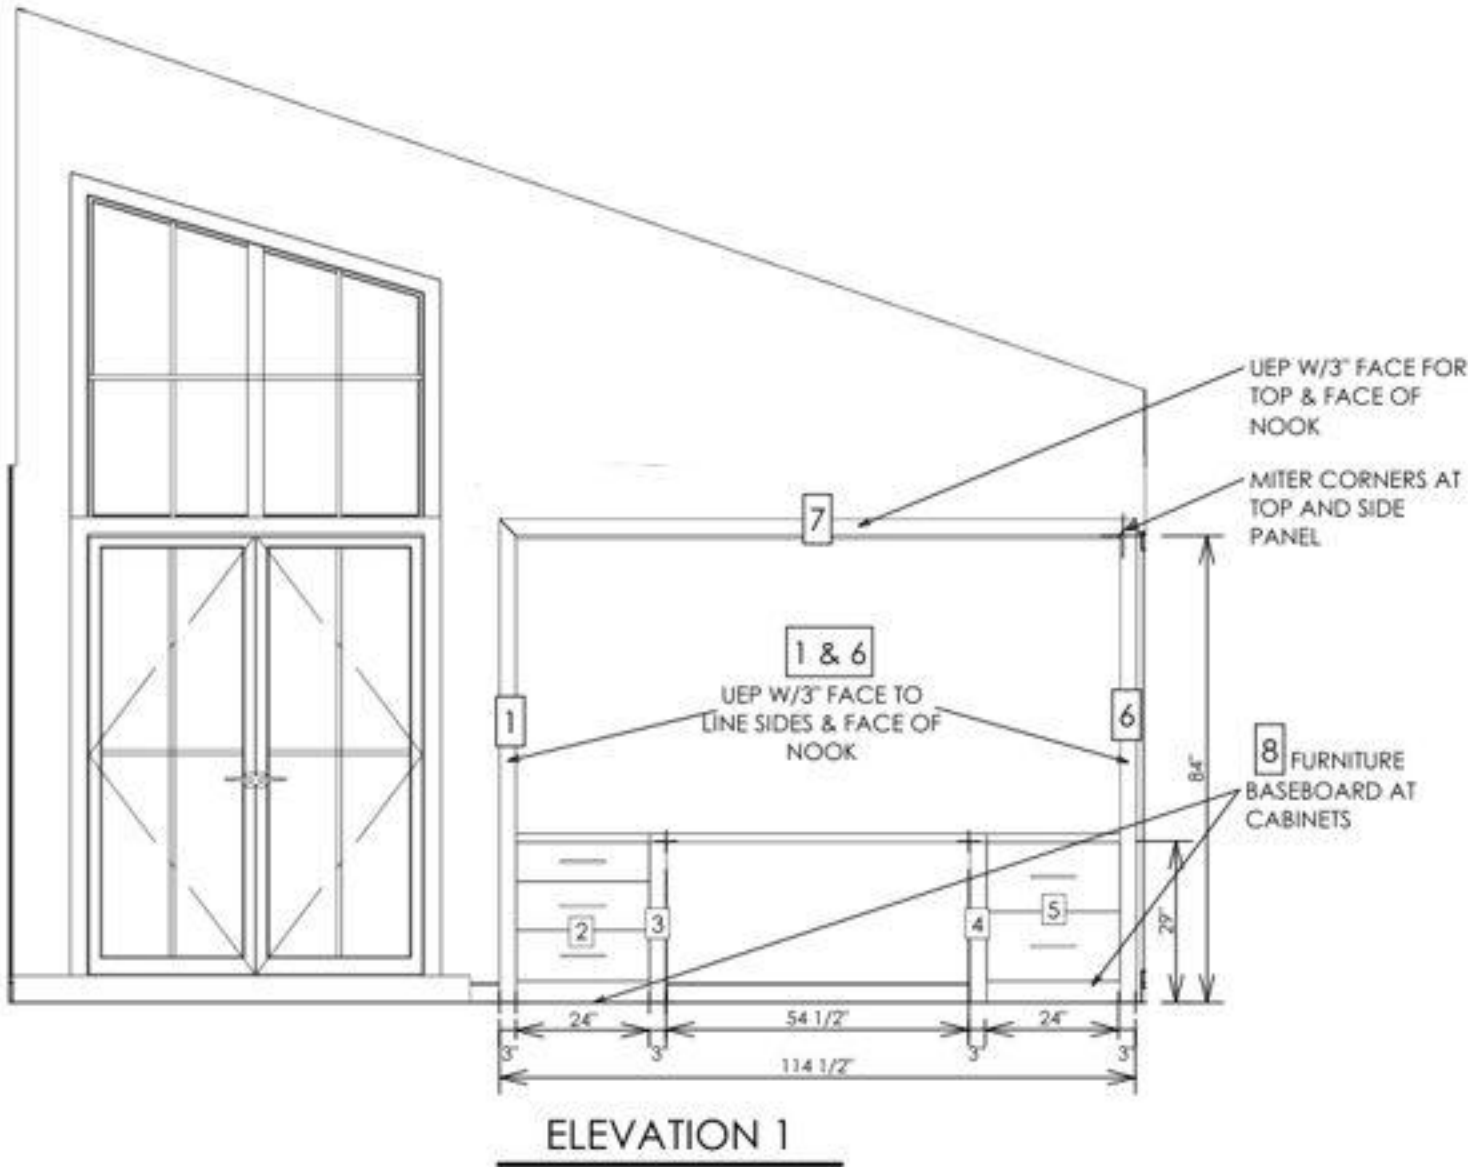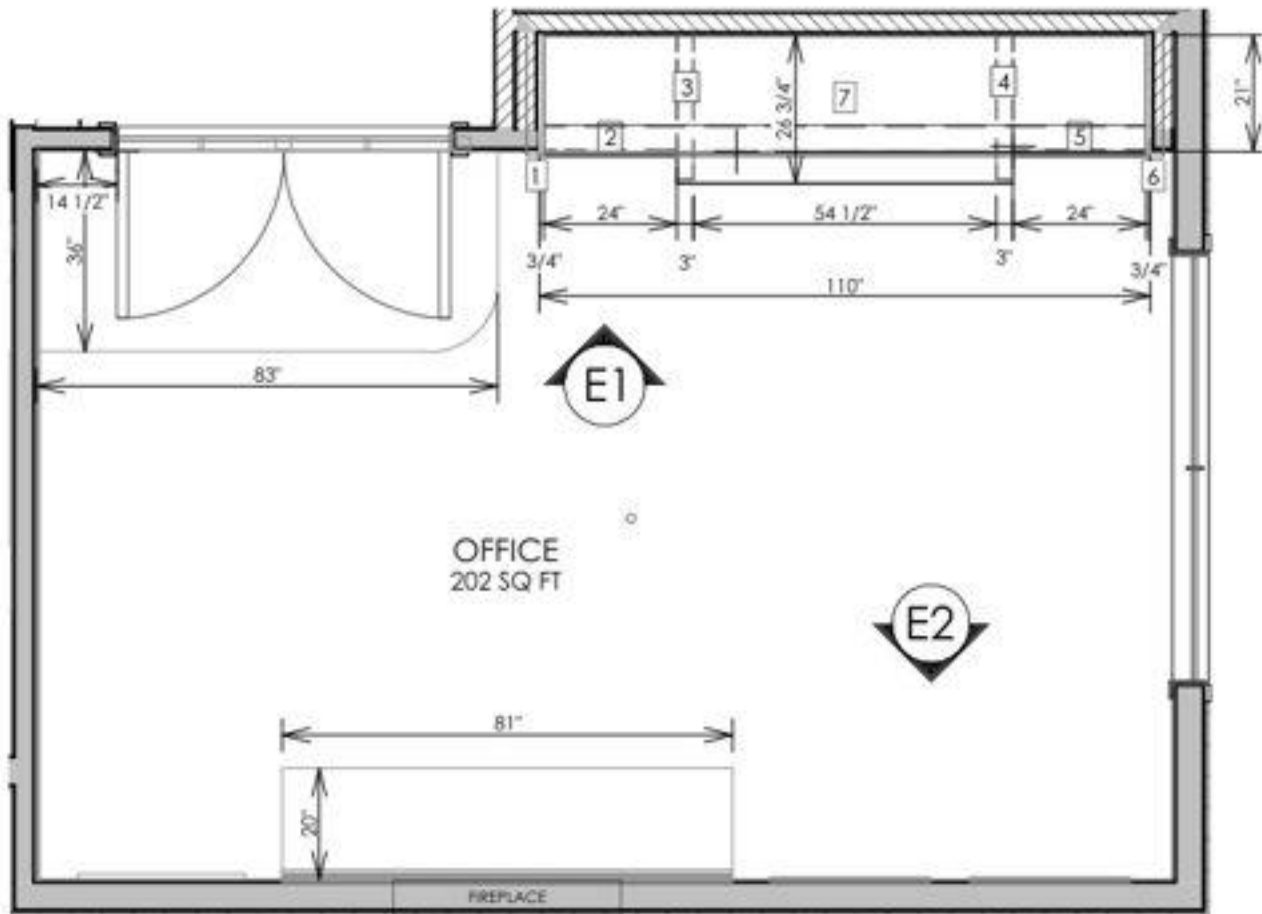
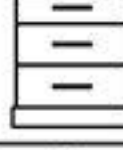
| OFFICE CABINET SCHEDULE: HICKORY EBONY |                                                                                     |       |     |          |        |         |                                                                     |
|----------------------------------------|-------------------------------------------------------------------------------------|-------|-----|----------|--------|---------|---------------------------------------------------------------------|
| NO                                     | ELEVATION                                                                           | LABEL | QTY | WIDTH    | HEIGHT | DEPTH   | DESCRIPTION                                                         |
|                                        |  | 1     | 1   | 3"       | 87"    | 21 3/4" | UEP W/3" FACE FOR SIDES & FACE OF NOOK - TRIM TO FIT                |
|                                        |  | 2     | 1   | 24"      | 29"    | 20 3/4" | BASE CABINET - FLUSH TOE KICK - FURNITURE BASEBOARD PROFILE F       |
|                                        |  | 3     | 1   | 3"       | 29"    | 26"     | 3" MITERED COLUMN                                                   |
|                                        |  | 4     | 1   | 3"       | 29"    | 26"     | 3" MITERED COLUMN                                                   |
|                                        |  | 5     | 1   | 24"      | 29"    | 20 3/4" | VANITY FILE DRAWER - FLUSH TOE KICK - FURNITURE BASEBOARD PROFILE F |
|                                        |  | 6     | 1   | 3"       | 87"    | 21 3/4" | UEP W/3" FACE FOR SIDES & FACE OF NOOK - TRIM TO FIT                |
|                                        |  | 7     | 1   | 114 1/2" | 3"     | 21 3/4" | UEP W/3" FACE FOR TOP & FACE OF NOOK - TRIM TO FIT                  |



LAUNDRY: HICKORY EBONY

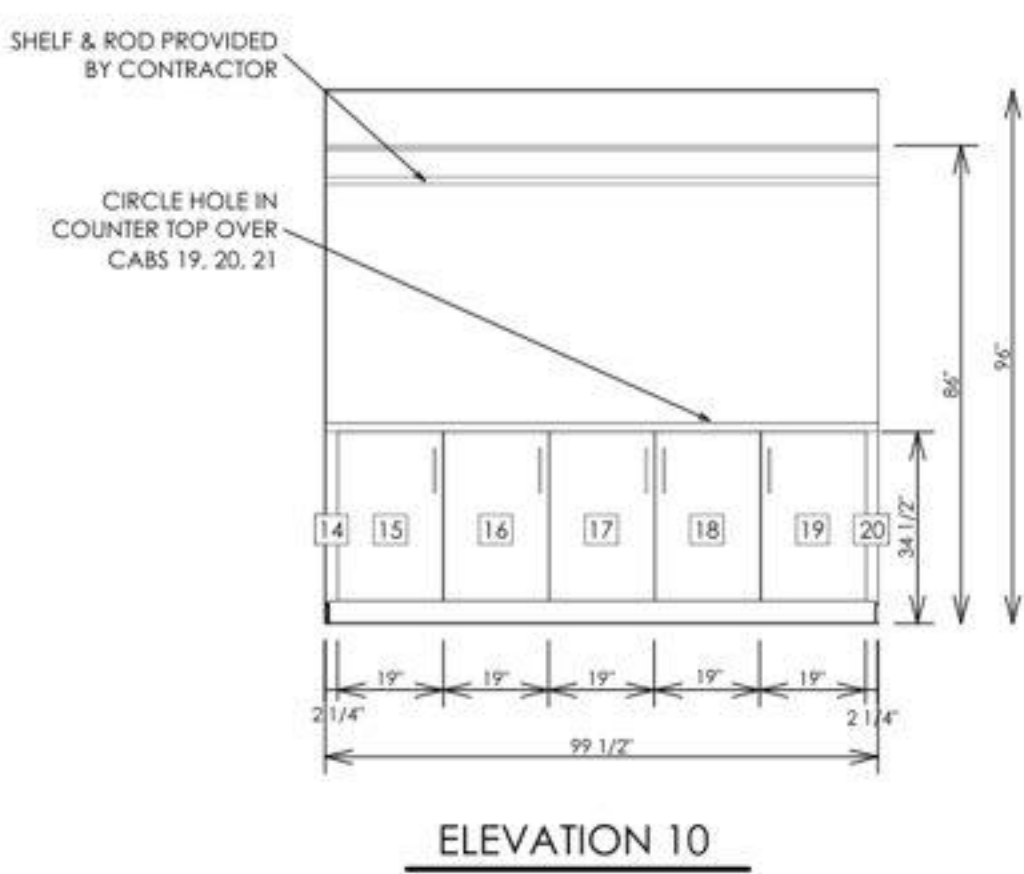
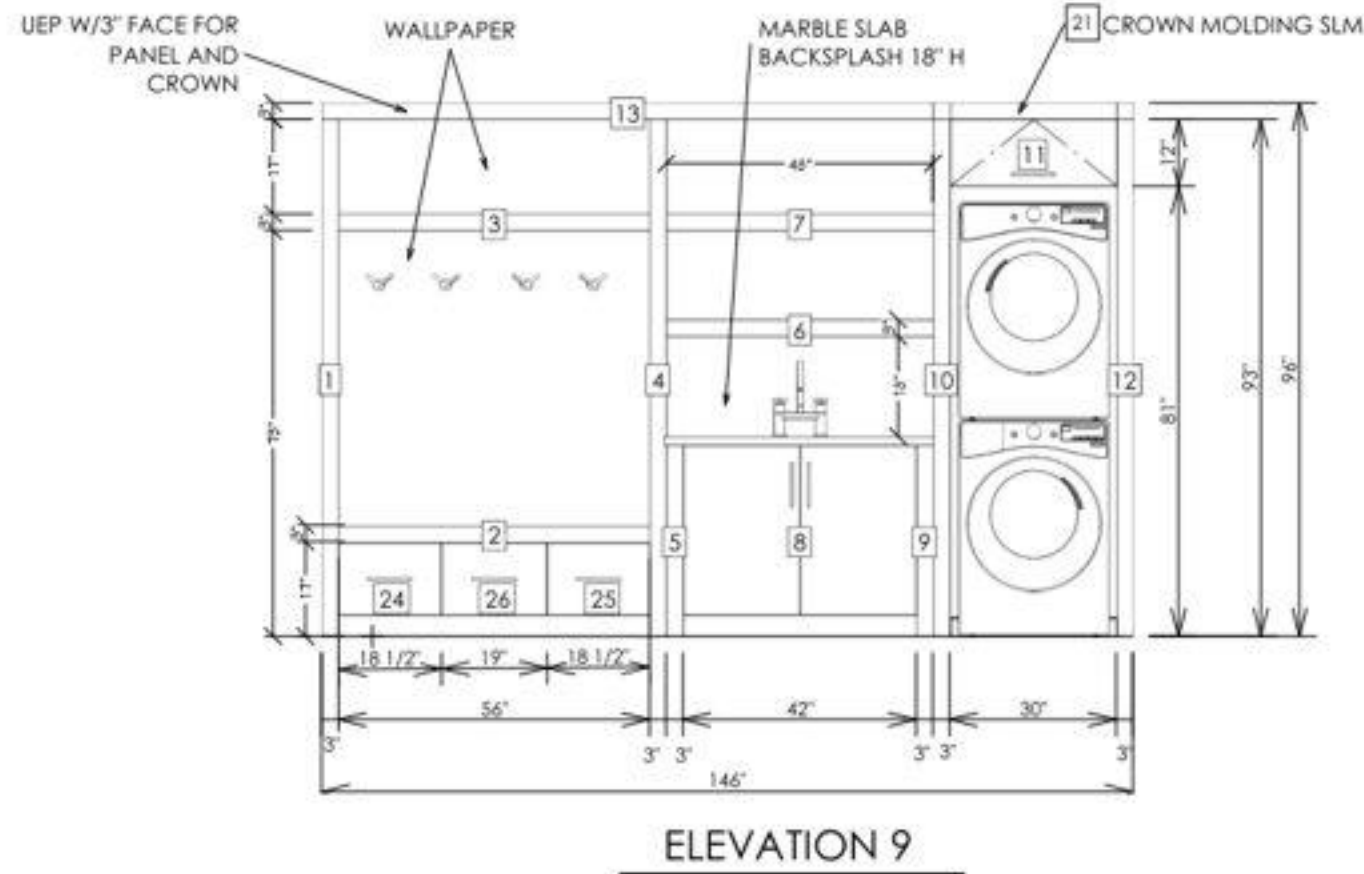


| LAUNDRY CABINET SCHEDULE: HICKORY EBONY                                               |       |     |       |         |       |                                                              |  |
|---------------------------------------------------------------------------------------|-------|-----|-------|---------|-------|--------------------------------------------------------------|--|
| 3D ELEVATION                                                                          | LABEL | QTY | WIDTH | HEIGHT  | DEPTH | DESCRIPTION                                                  |  |
|  | 1     | 1   | 3"    | 93"     | 15"   | UEP W/6" FACE - NO TOE NOTCH - TRIM FACE TO FIT AT WALL      |  |
|  | 2     | 1   | 56"   | 3"      | 15"   | 3" MITERED COLUMNS AS FLOATING SHELVES                       |  |
|  | 3     | 1   | 56"   | 3"      | 15"   | 3" MITERED COLUMNS AS FLOATING SHELVES                       |  |
|  | 4     | 1   | 3"    | 93"     | 15"   | 3" MITERED COLUMN                                            |  |
|  | 5     | 1   | 3"    | 34 1/2" | 25"   | 3" MITERED COLUMN                                            |  |
|  | 6     | 1   | 48"   | 3"      | 15"   | 3" MITERED COLUMNS AS FLOATING SHELVES                       |  |
|  | 7     | 1   | 48"   | 3"      | 15"   | 3" MITERED COLUMNS AS FLOATING SHELVES                       |  |
|  | 8     | 1   | 42"   | 34 1/2" | 24"   | SINK BASE - FULL HEIGHT DOORS                                |  |
|  | 9     | 1   | 3"    | 34 1/2" | 25"   | 3" MITERED COLUMN                                            |  |
|  | 10    | 1   | 3"    | 93"     | 30"   | 3" MITERED COLUMN                                            |  |
|  | 11    | 1   | 30"   | 12"     | 29"   | WALL CABINET - TOP HINGE                                     |  |
|  | 12    | 1   | 3"    | 93"     | 30"   | UEP W/6" FACE - NO TOE NOTCH - TRIM FACE TO FIT AT WALL      |  |
|  | 13    | 1   | 110"  | 3"      | 15"   | UEP W/3" FACE - NO TOE NOTCH - TRIM TO FIT - ORDER 120' LONG |  |


| NO | ELEVATION | LABEL | QTY | WIDTH   | HEIGHT  | DEPTH | DESCRIPTION             |
|----|-----------|-------|-----|---------|---------|-------|-------------------------|
| 14 | 1         |       | 1   | 2 1/4"  | 34 1/2" | 12"   | FILLER                  |
| 15 | 1         |       | 1   | 19"     | 34 1/2" | 12"   | BASE CABINET            |
| 16 | 1         |       | 1   | 19"     | 34 1/2" | 12"   | BASE CABINET            |
| 17 | 1         |       | 1   | 19"     | 34 1/2" | 12"   | BASE CABINET            |
| 18 | 1         |       | 1   | 19"     | 34 1/2" | 12"   | BASE CABINET            |
| 19 | 1         |       | 1   | 19"     | 34 1/2" | 12"   | BASE CABINET            |
| 20 | 1         |       | 1   | 2 1/4"  | 34 1/2" | 12"   | FILLER                  |
| 24 | 1         |       | 1   | 18 1/2" | 17"     | 14"   | BASE WINDOW SEAT DRAWER |
| 25 | 1         |       | 1   | 18 1/2" | 17"     | 14"   | BASE WINDOW SEAT DRAWER |
| 26 | 1         |       | 1   | 19"     | 17"     | 14"   | BASE WINDOW SEAT DRAWER |





PRIMARY BATH: ACCESSIBLE BEIGE PAINT

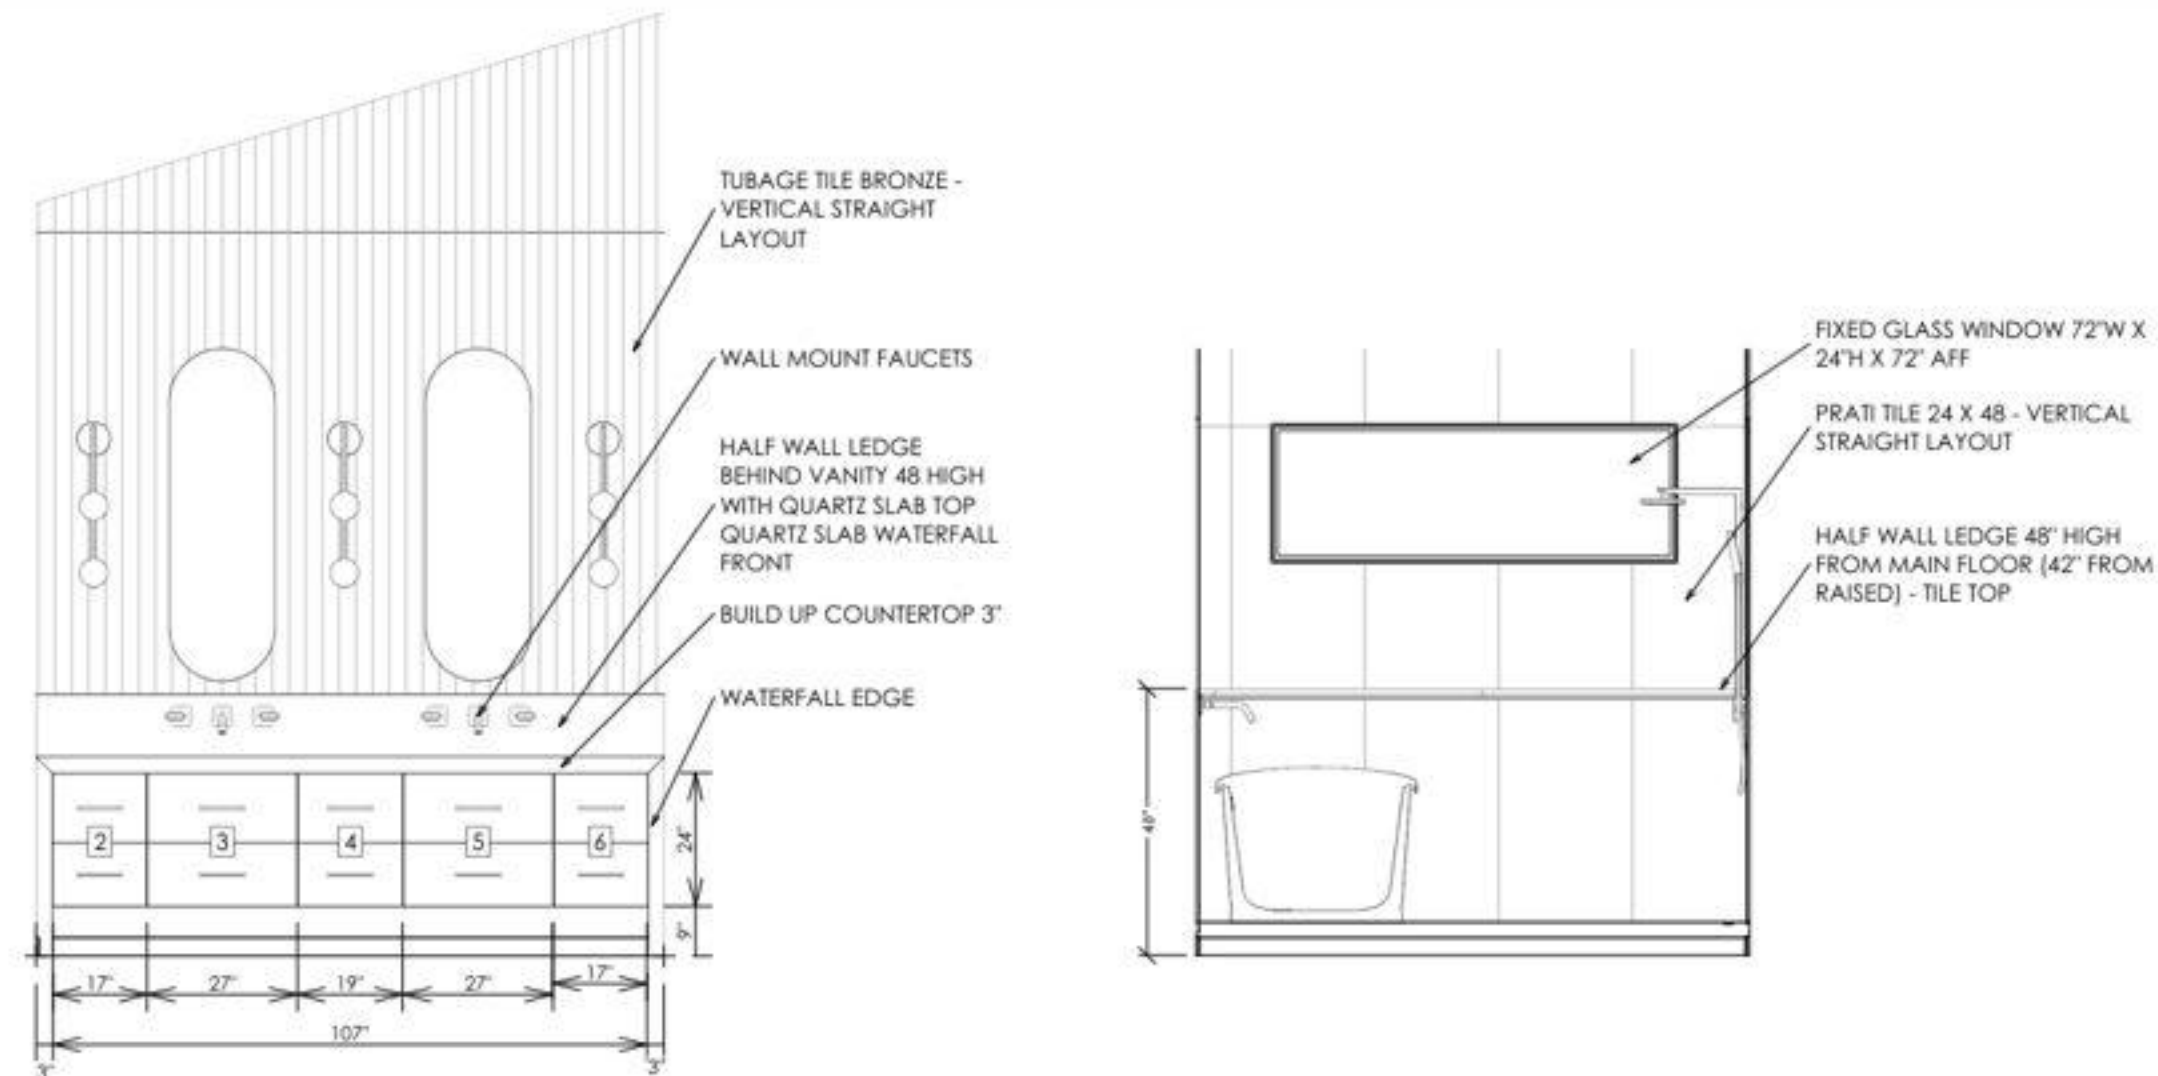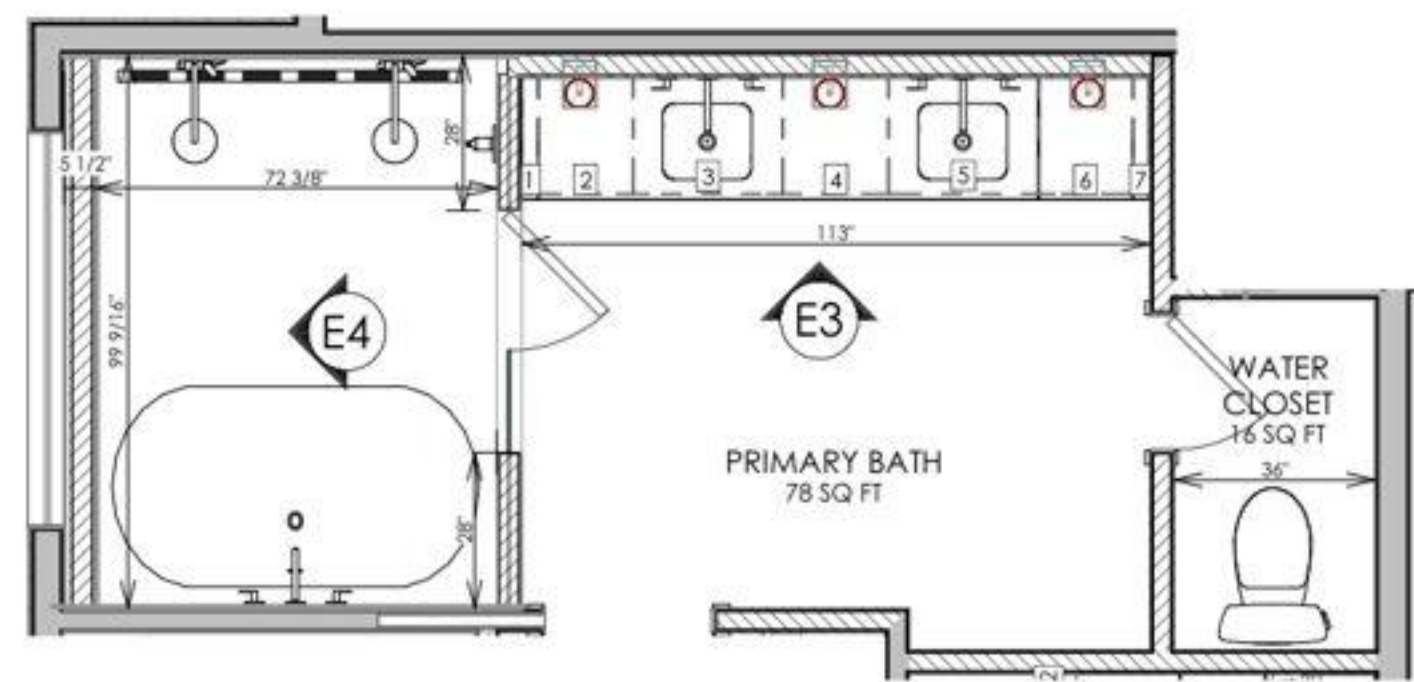

| PRIMARY BATH CABINET SCHEDULE: ACCESSIBLE BEIGE PAINT |           |       |     |       |        |       |
|-------------------------------------------------------|-----------|-------|-----|-------|--------|-------|
| ID                                                    | ELEVATION | LABEL | QTY | WIDTH | HEIGHT | DEPTH |
| 1                                                     |           |       | 1   | 3"    | 24"    | 18"   |
| 2                                                     |           |       | 1   | 17"   | 24"    | 21"   |
| 3                                                     |           |       | 1   | 27"   | 24"    | 21"   |
| 4                                                     |           |       | 1   | 19"   | 24"    | 21"   |
| 5                                                     |           |       | 1   | 27"   | 24"    | 21"   |
| 6                                                     |           |       | 1   | 17"   | 24"    | 21"   |
| 7                                                     |           |       | 1   | 3"    | 24"    | 18"   |



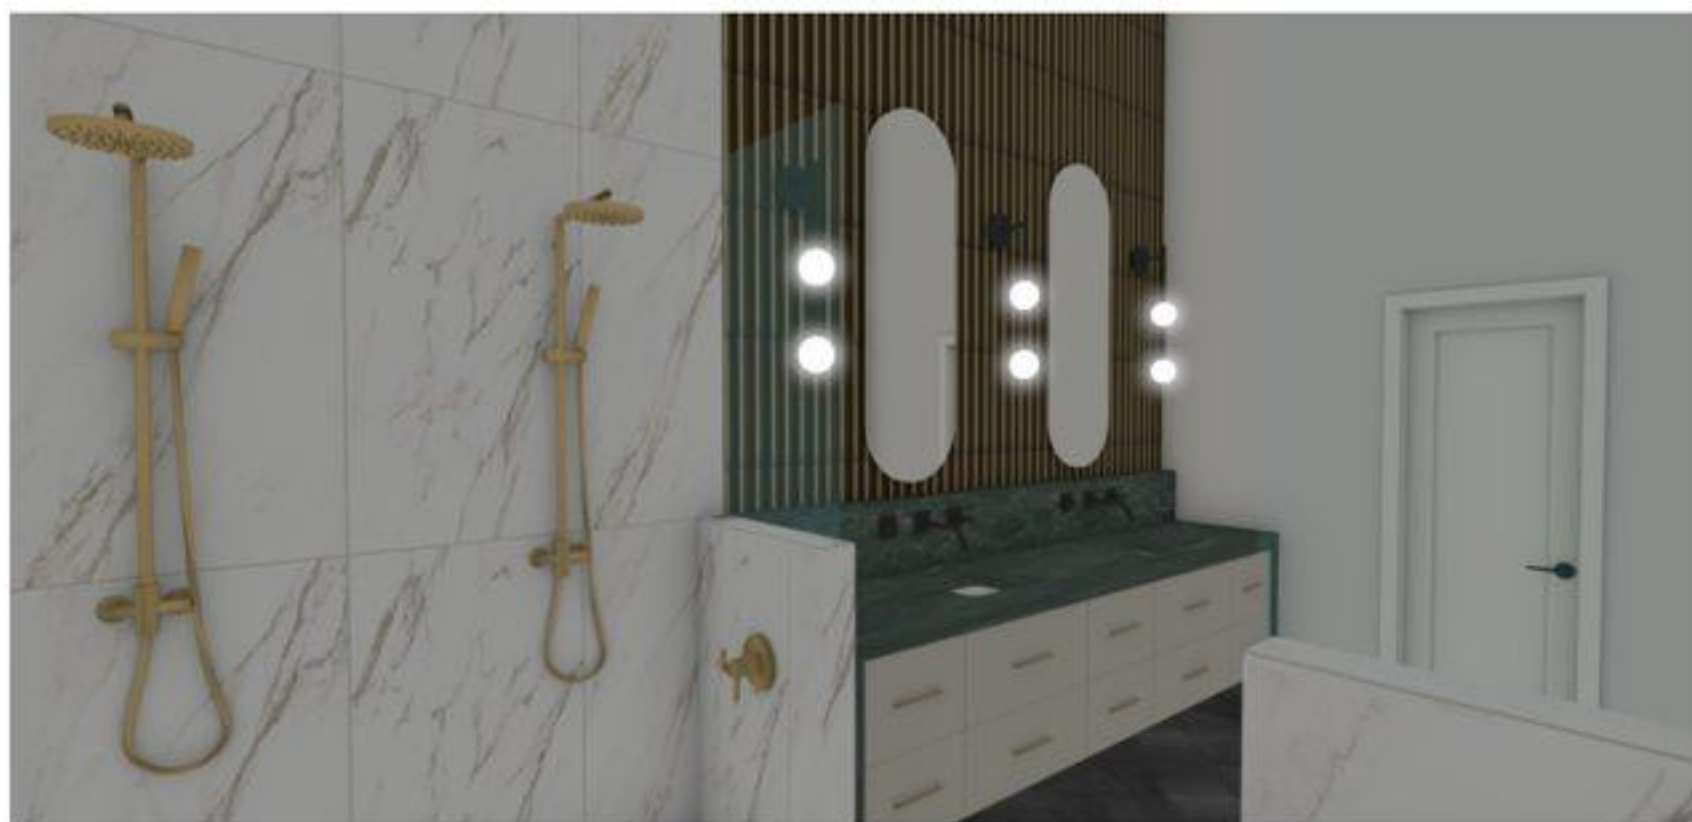


PRIMARY CLOSET: ACCESSIBLE BEIGE PAINT

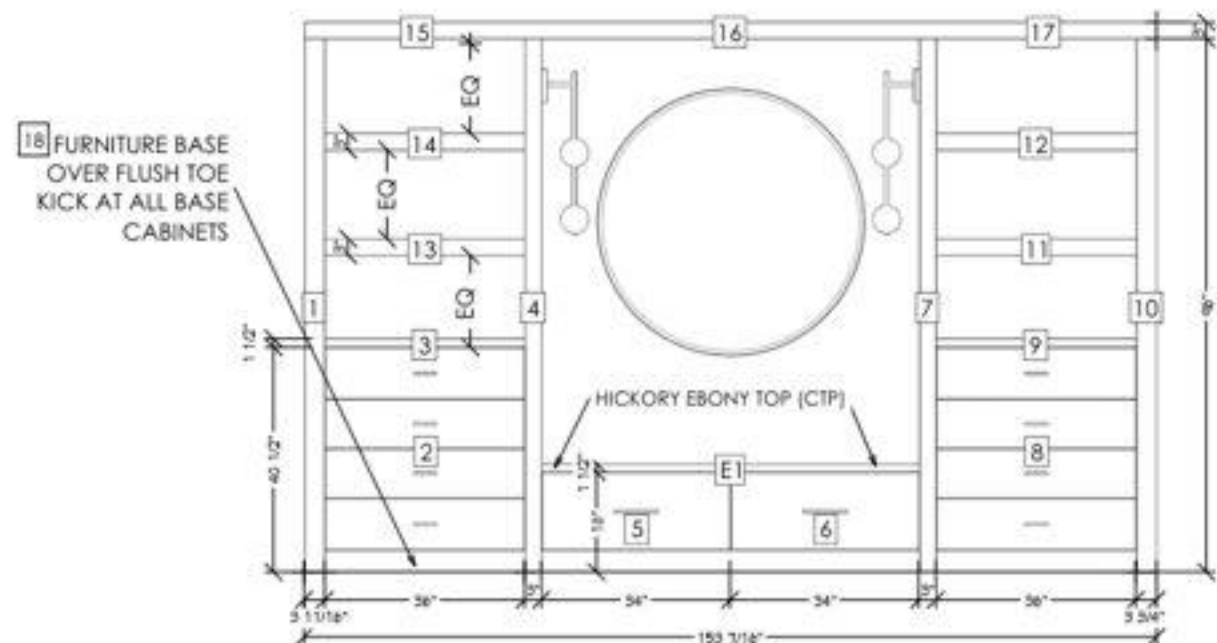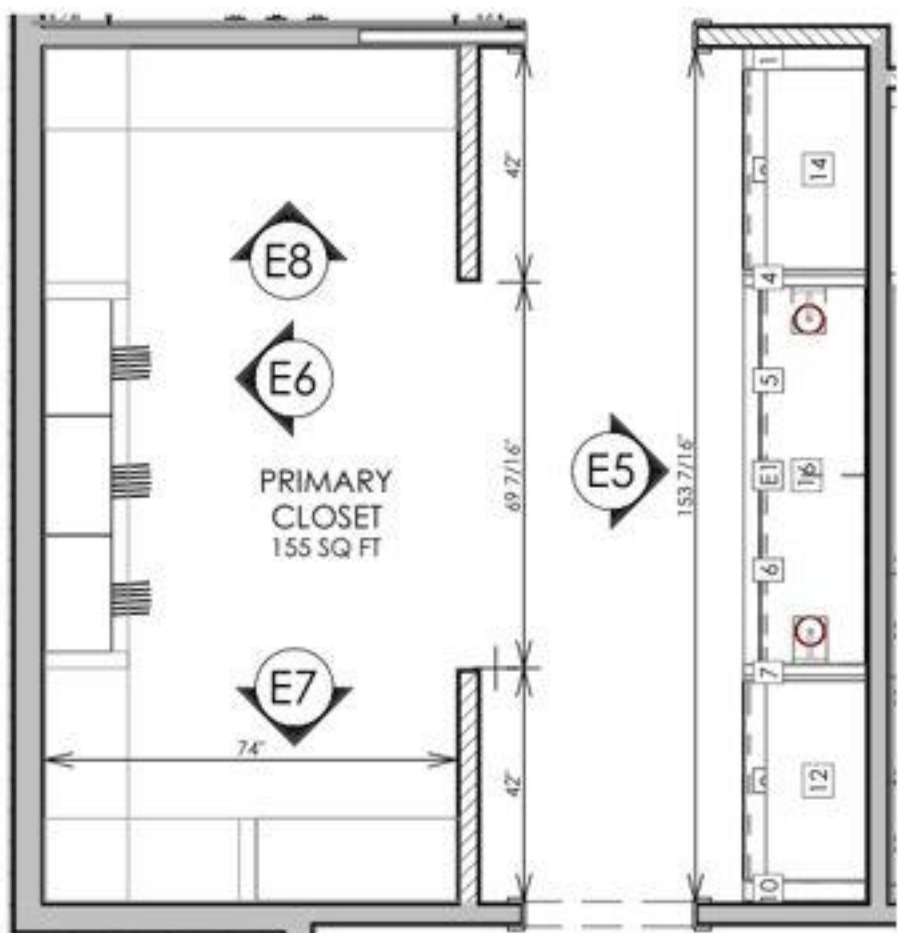



| PRIMARY CLOSET CABINET SCHEDULE: ACCESSIBLE BEIGE PAINT |           |       |     |          |         |       |
|---------------------------------------------------------|-----------|-------|-----|----------|---------|-------|
| ID                                                      | ELEVATION | LABEL | QTY | WIDTH    | HEIGHT  | DEPTH |
| 1                                                       |           |       | 1   | 3 11/16" | 96"     | 22"   |
| 2                                                       |           |       | 1   | 36"      | 40 1/2" | 21"   |
| 3                                                       |           |       | 1   | 36"      | 1 1/2"  | 22"   |
| 4                                                       |           |       | 1   | 3"       | 96"     | 22"   |
| 5                                                       |           |       | 1   | 34"      | 18"     | 18"   |
| 6                                                       |           |       | 1   | 34"      | 18"     | 18"   |
| 7                                                       |           |       | 1   | 3"       | 96"     | 22"   |
| 8                                                       |           |       | 1   | 36"      | 40 1/2" | 21"   |
| 9                                                       |           |       | 1   | 36"      | 1 1/2"  | 22"   |
| 10                                                      |           |       | 1   | 3 11/16" | 96"     | 22"   |
| 11                                                      |           |       | 1   | 36"      | 3"      | 18"   |
| 12                                                      |           |       | 1   | 36"      | 3"      | 18"   |
| 13                                                      |           |       | 1   | 36"      | 3"      | 18"   |


| PRIMARY CLOSET CABINET SCHEDULE: ACCESSIBLE BEIGE PAINT |           |       |     |           |        |       |
|---------------------------------------------------------|-----------|-------|-----|-----------|--------|-------|
| ID                                                      | ELEVATION | LABEL | QTY | WIDTH     | HEIGHT | DEPTH |
| 14                                                      |           |       | 1   | 36"       | 3"     | 18"   |
| 15                                                      |           |       | 1   | 40 11/16" | 3"     | 22"   |
| 16                                                      |           |       | 1   | 72"       | 3"     | 22"   |
| 17                                                      |           |       | 1   | 40 11/16" | 3"     | 22"   |
| E1                                                      |           |       | 1   | 68"       | 1 1/2" | 19"   |

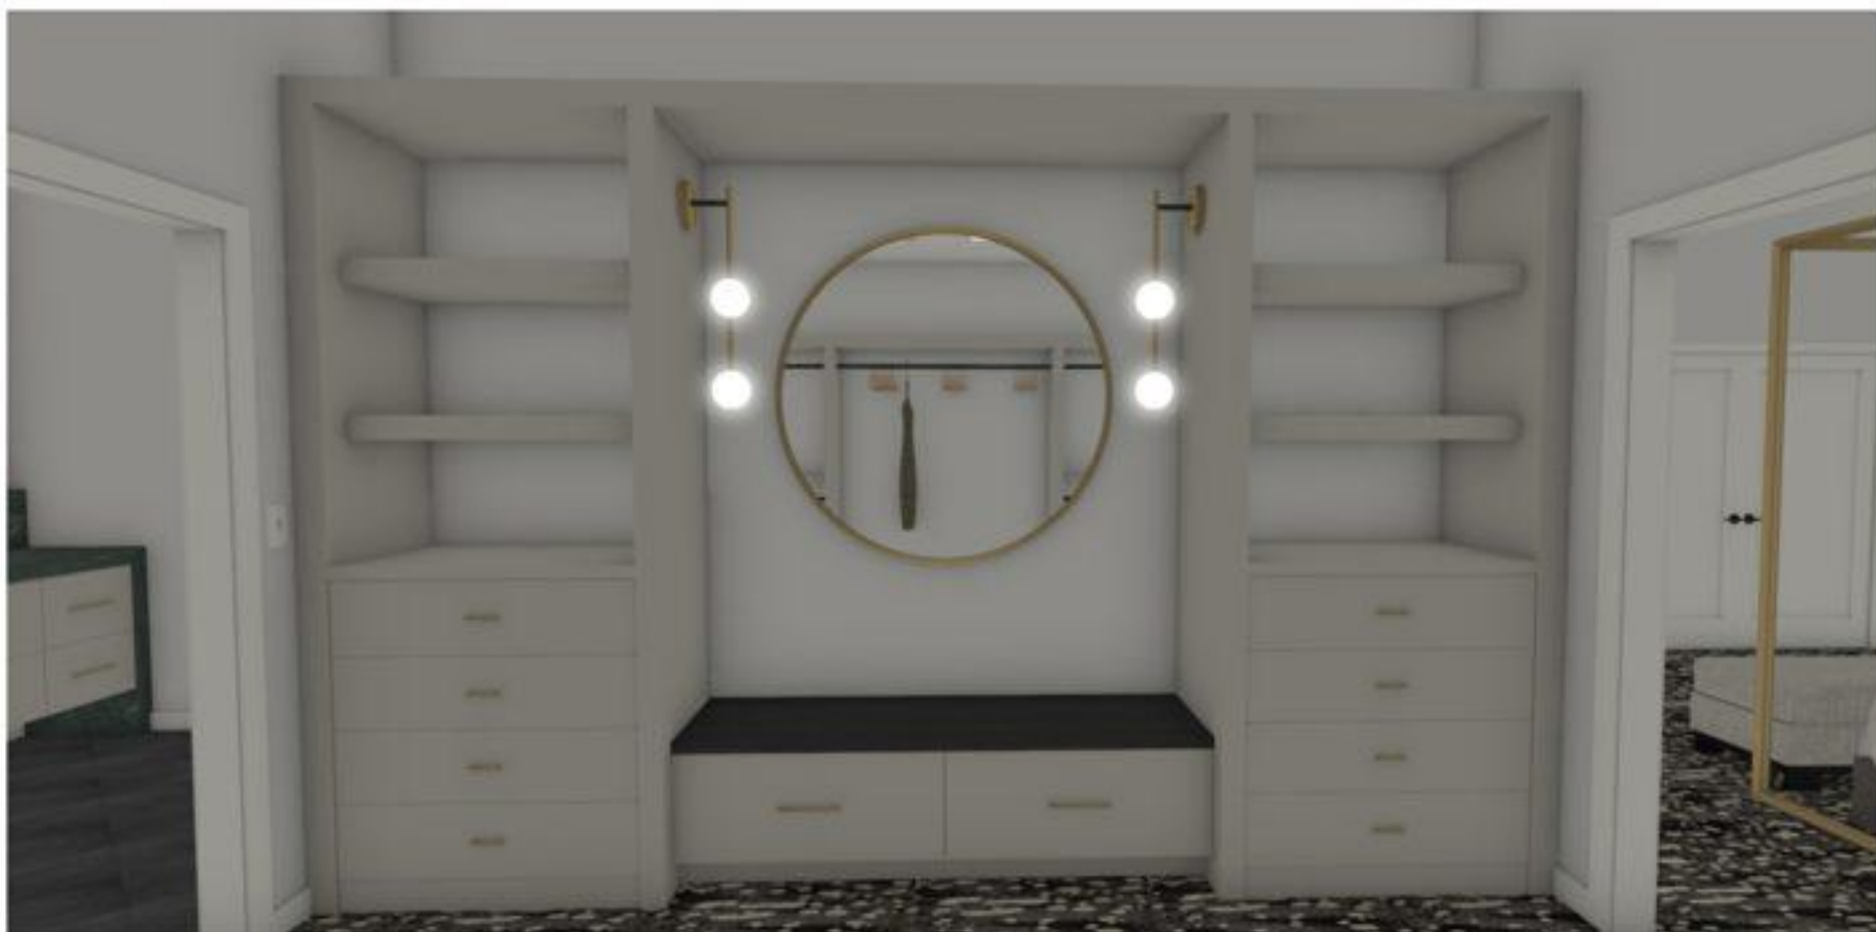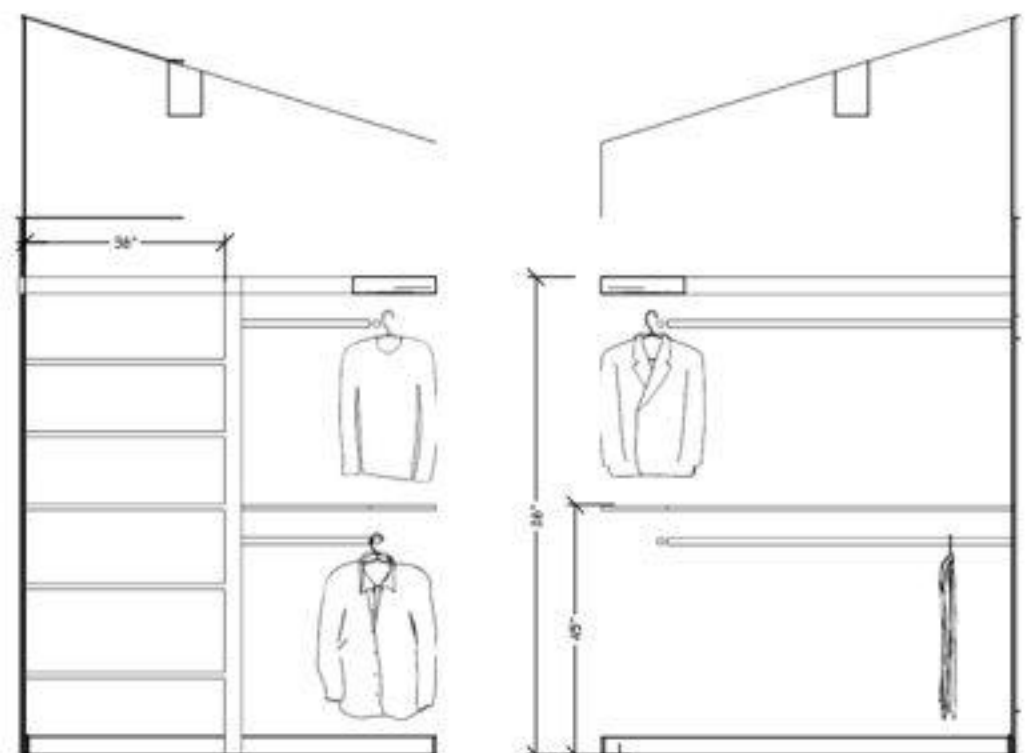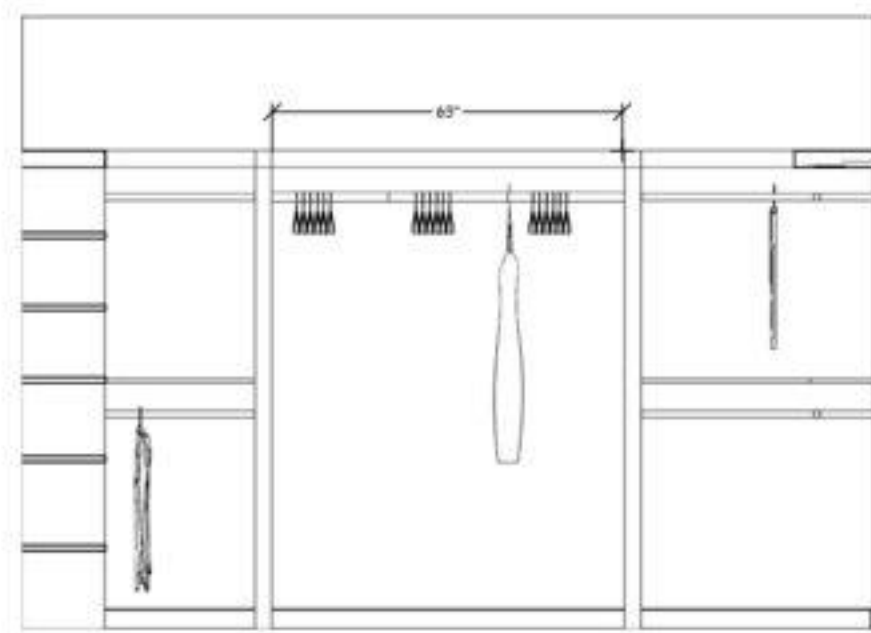

\* CONTRACTOR TO SUPPLY AND BUILD CLOSET SHELVING


POWDER: HICKORY EBONY

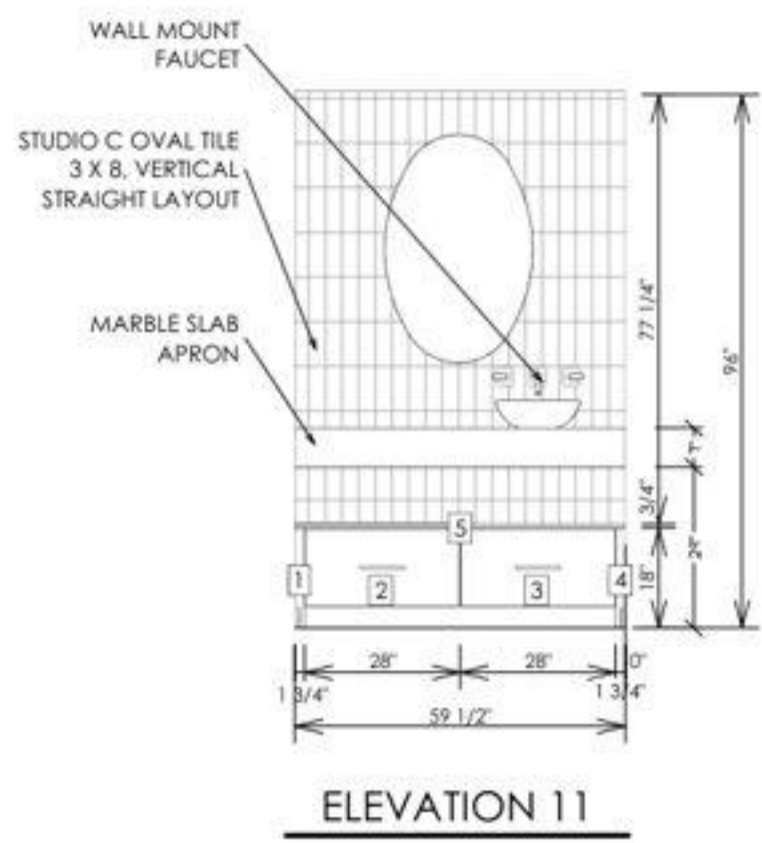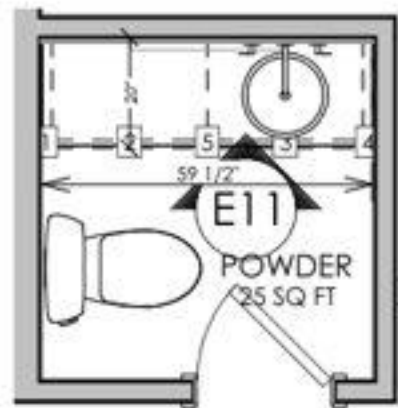
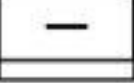
| POWDER CABINET SCHEDULE: HICKORY EBONY |                                                                                     |       |     |         |        |         |                                    |
|----------------------------------------|-------------------------------------------------------------------------------------|-------|-----|---------|--------|---------|------------------------------------|
| NO                                     | ELEVATION                                                                           | LABEL | QTY | WIDTH   | HEIGHT | DEPTH   | DESCRIPTION                        |
|                                        |  | 1     | 1   | 1 3/4"  | 18"    | 19"     | FILLER                             |
|                                        |  | 2     | 1   | 28"     | 18"    | 18"     | 1 DRAWER<br>BASE                   |
|                                        |  | 3     | 1   | 28"     | 18"    | 18"     | 1 DRAWER<br>BASE                   |
|                                        |  | 4     | 1   | 1 3/4"  | 18"    | 19"     | FILLER                             |
|                                        |  | 5     | 1   | 59 1/2" | 3/4"   | 19 1/2" | 3/4" PANEL<br>TOP - TRIM<br>TO FIT |




BAR & LIVING

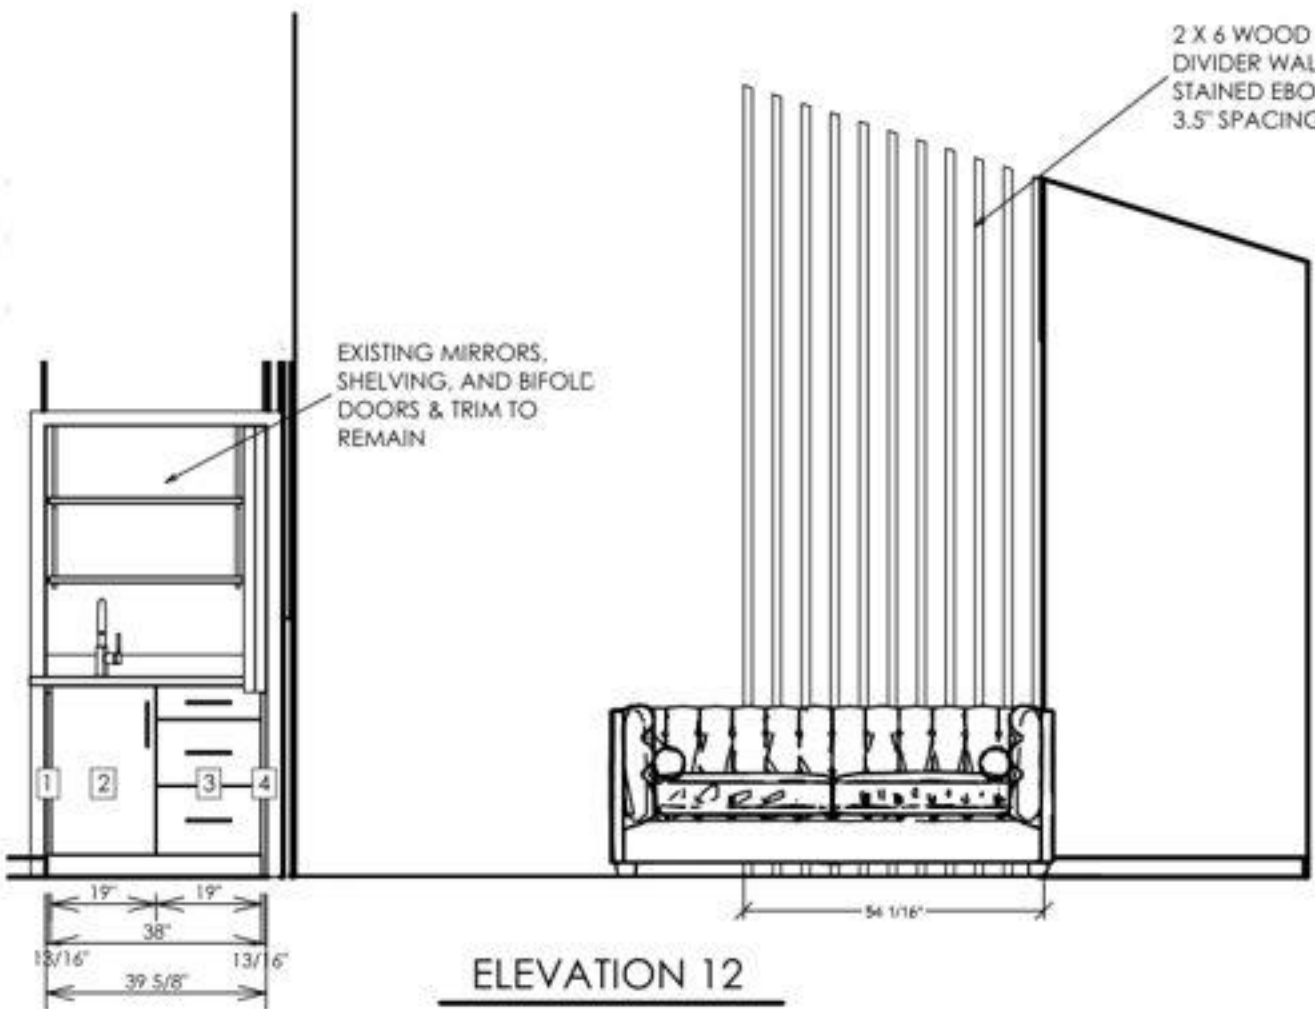


| BAR CABINET SCHEDULE: HICKORY EBONY |                                                                                     |       |     |        |         |       |                  |
|-------------------------------------|-------------------------------------------------------------------------------------|-------|-----|--------|---------|-------|------------------|
| NO                                  | ELEVATION                                                                           | LABEL | QTY | WIDTH  | HEIGHT  | DEPTH | DESCRIPTION      |
|                                     |    |       | 1   | 13/16" | 34 1/2" | 24"   | FILLER           |
|                                     |    |       | 2   | 19"    | 34 1/2" | 24"   | BASE CABINET     |
|                                     |  |       | 3   | 19"    | 34 1/2" | 24"   | 3 DRAWER<br>BASE |
|                                     |  |       | 4   | 13/16" | 34 1/2" | 24"   | FILLER           |



MISC. 3D'S

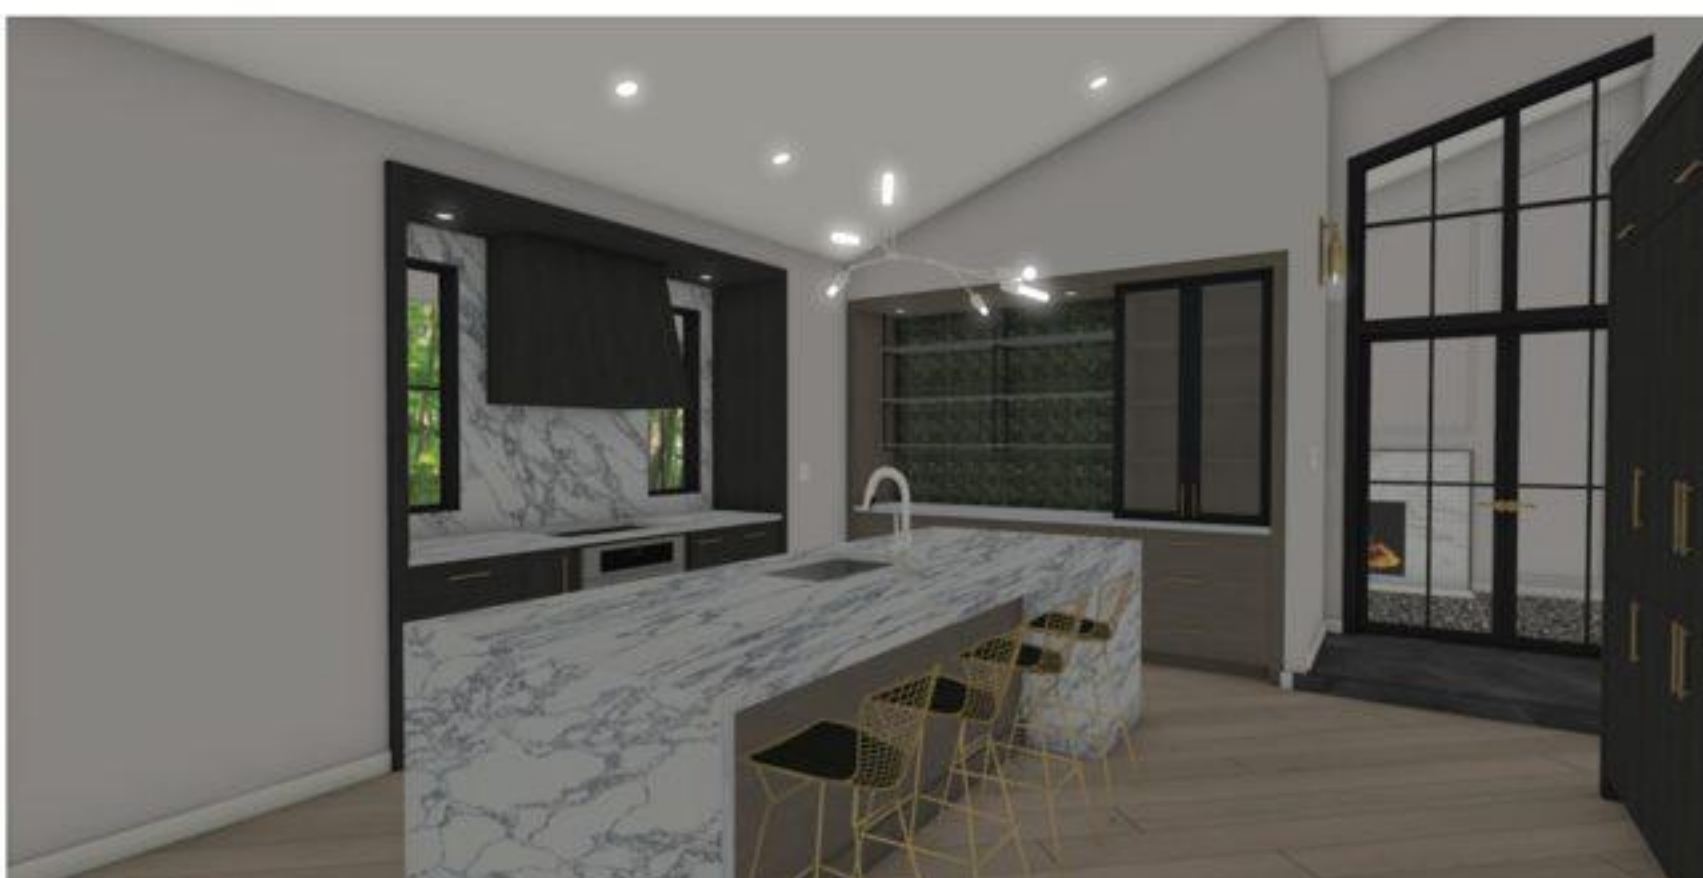

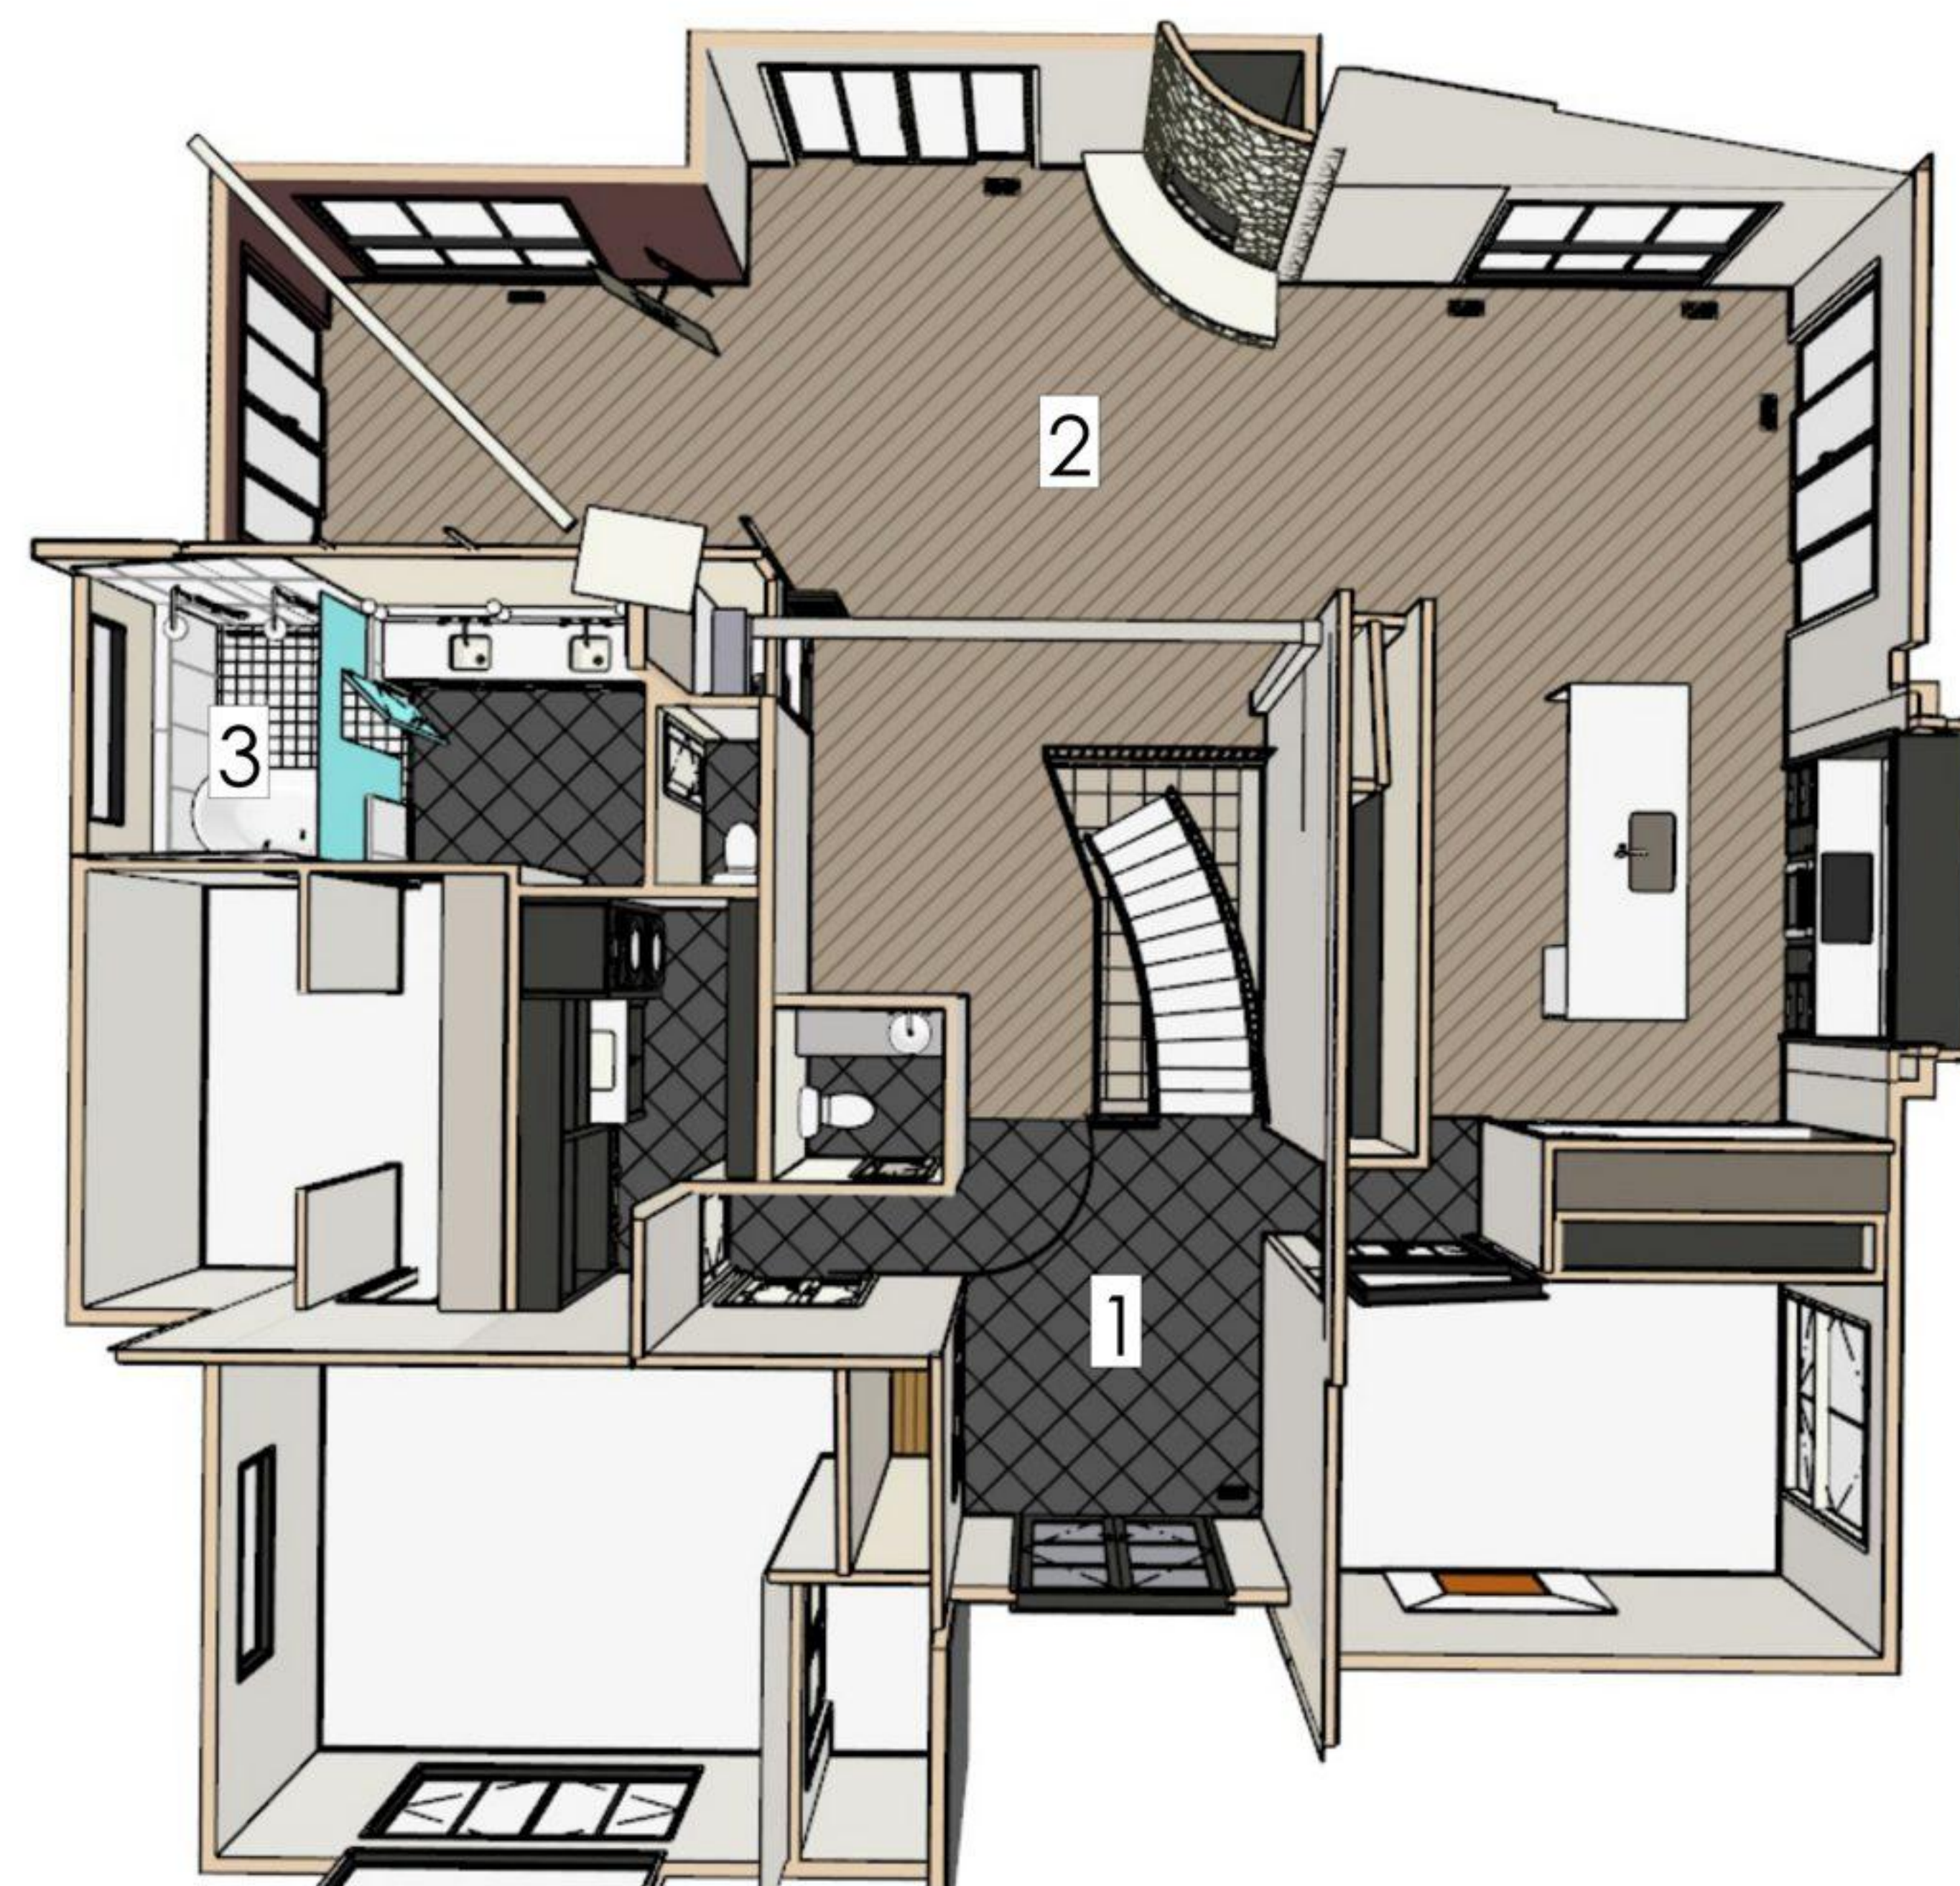

FINISH PLAN

SCALE: NTS

### TILE & WOOD FLOOR LAYOUTS:

- 1 16 x 16 Honed Slate Tile, Ostrich Gray, Diagonal layout
- 2 Khars Oak Plank, Loft White, Diagonal layout
- 3 Prati 4 x 4 Mosaic, Calacatta Borghini, Straight layout

\* Black Schluter at floor transitions at Entry & Kitchen

\* White or Bright White Schluter (match to floor tile) at floor transition at shower step in Primary Bath